


T.2NR.3W.W.M.

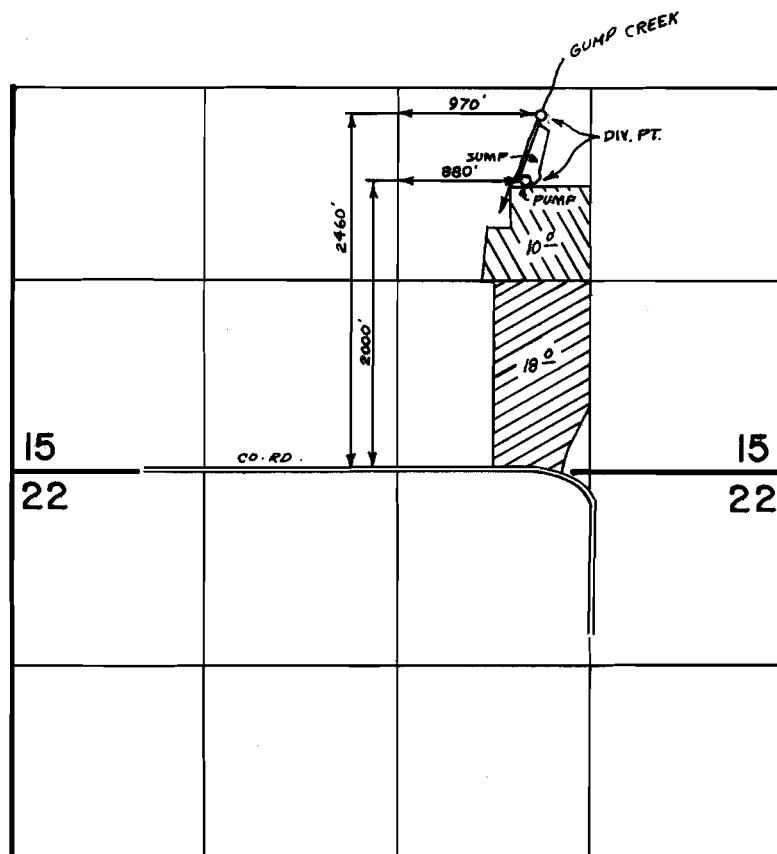

 PRIMARY
 SUPPLEMENTAL

FINAL PROOF SURVEY
UNDER

44298 33084
Application No. R-44297 Permit No. R-5123
IN NAME OF

MARTIN STADELMAN

Surveyed JUN 26 1973, by R.G. MUCKEN