


T.28&3 N.R.3W.W.M.

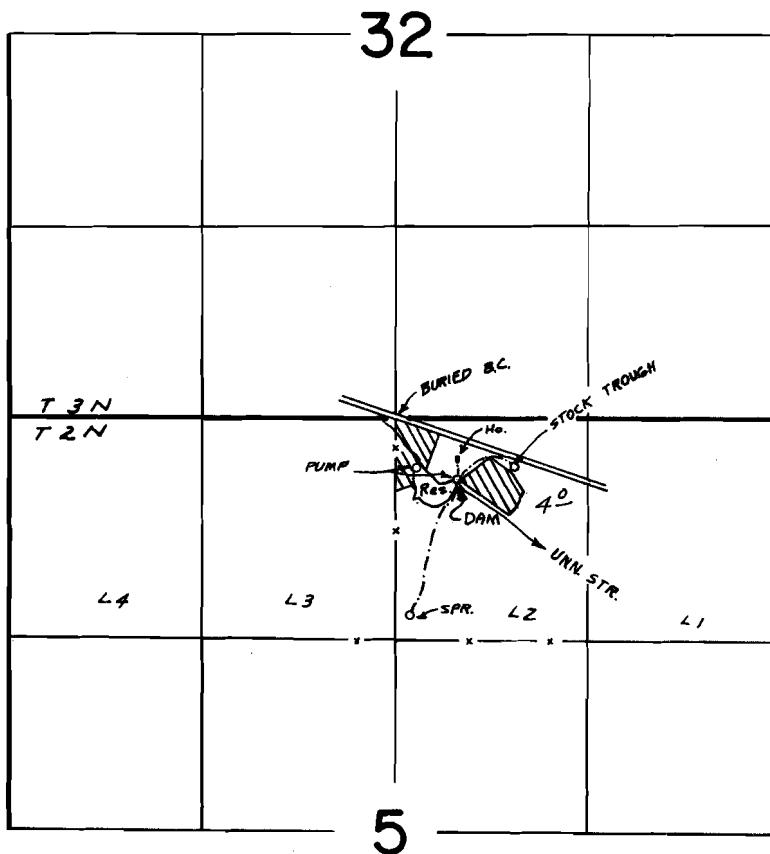

DAM 430' S & 420' E, SPRING 1350' S & 100' E FROM N¹/₄ COR. SEC. 5

FINAL PROOF SURVEY

UNDER

Application No. 48880 R-48673 Permit No. 36329 R-5879
IN NAME OF

THOMAS W. MASON

Surveyed JUN 26 1973, by R.G. MUCKEN