


T.2S.R.IW.W.M.

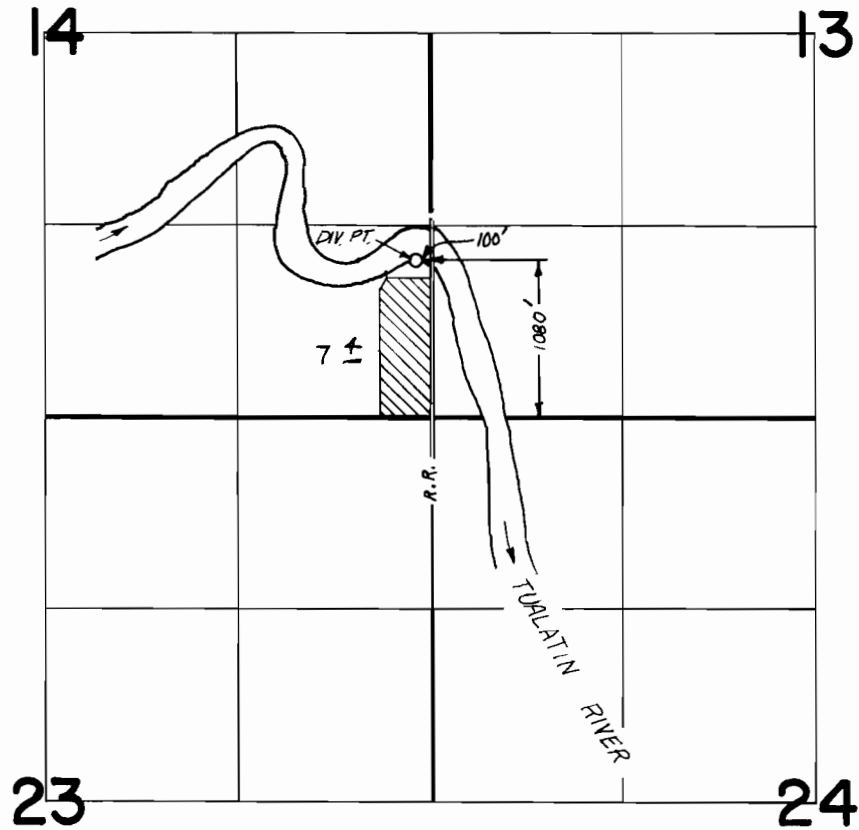

**FINAL PROOF SURVEY**  
UNDER

Application No. 42302 Permit No. 31633  
IN NAME OF

HARLOW & PATRICIA HICKOX

Surveyed OCT 6 1972, by L. GOULD