


T. 2 S. R. 1 W. W. M.

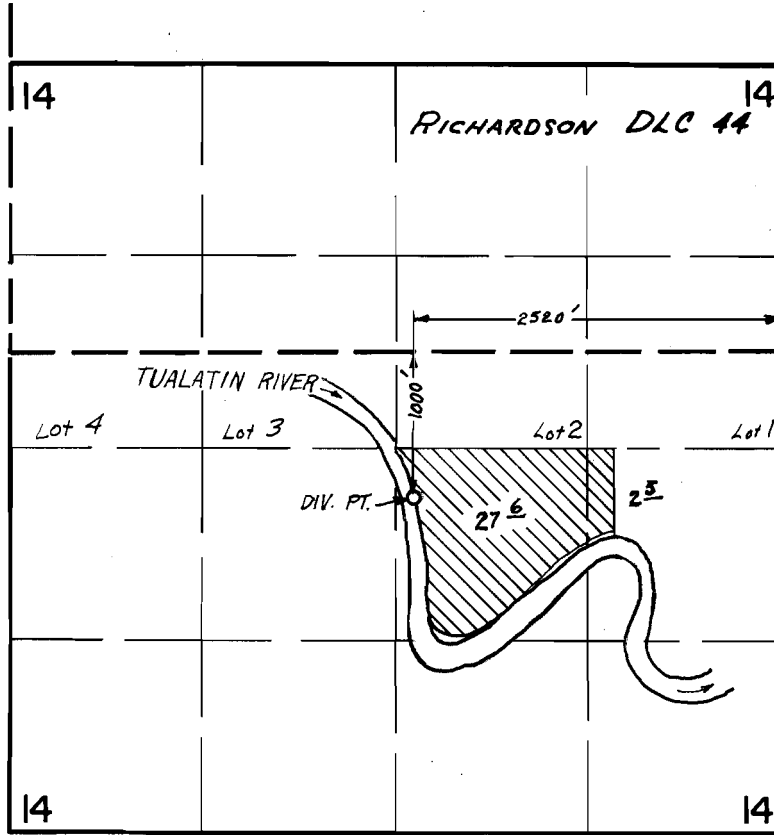

FINAL PROOF SURVEY UNDER

Application No. 43923 Permit No. 32306
IN NAME OF

CITY OF TIGARD

Surveyed OCT 3 1972, by L. GOULD