


# T. 1 N. R. 4 W. W.M.

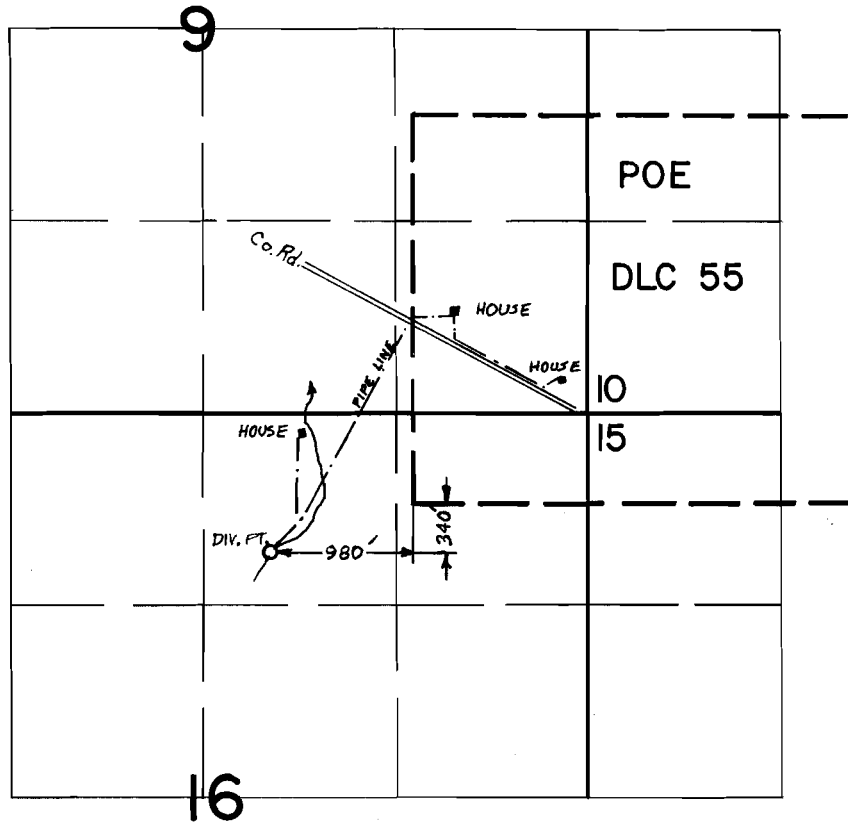

## FINAL PROOF SURVEY UNDER

Application No. 43928 Permit No. 32828

IN NAME OF

L. E. BAMFORD

Surveyed JUNE 8 1972, by L. GOULD