


T.2N.R.2W.W.M.

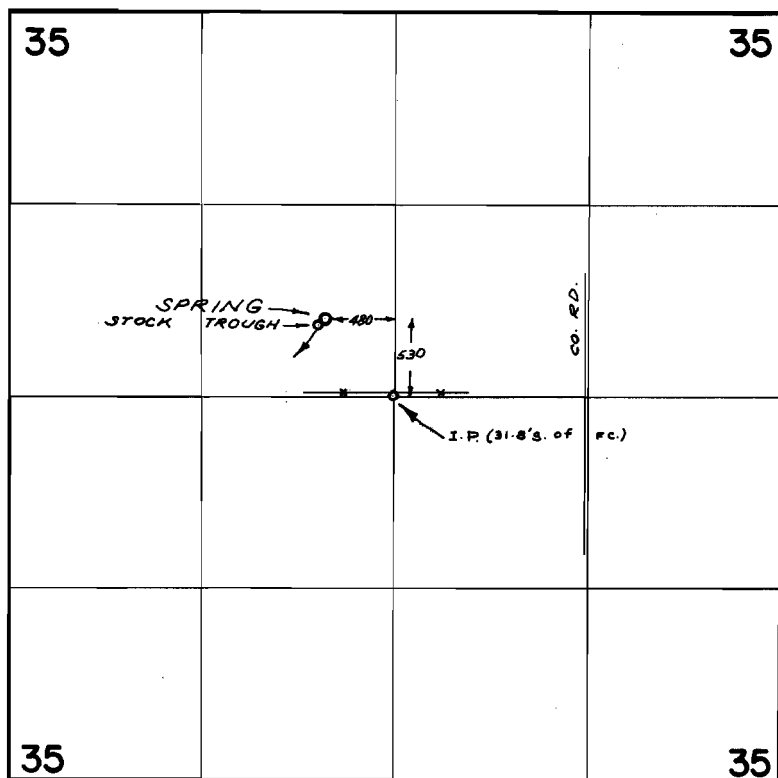

FINAL PROOF SURVEY
UNDER

Application No. 44075 Permit No. 32861
IN NAME OF

GEORGE TEUFEL & LILLIAN TEUFEL

Surveyed SEPT. 12, 1972, by R. MUCKEN