


T.I.N.R.3W.W.M.

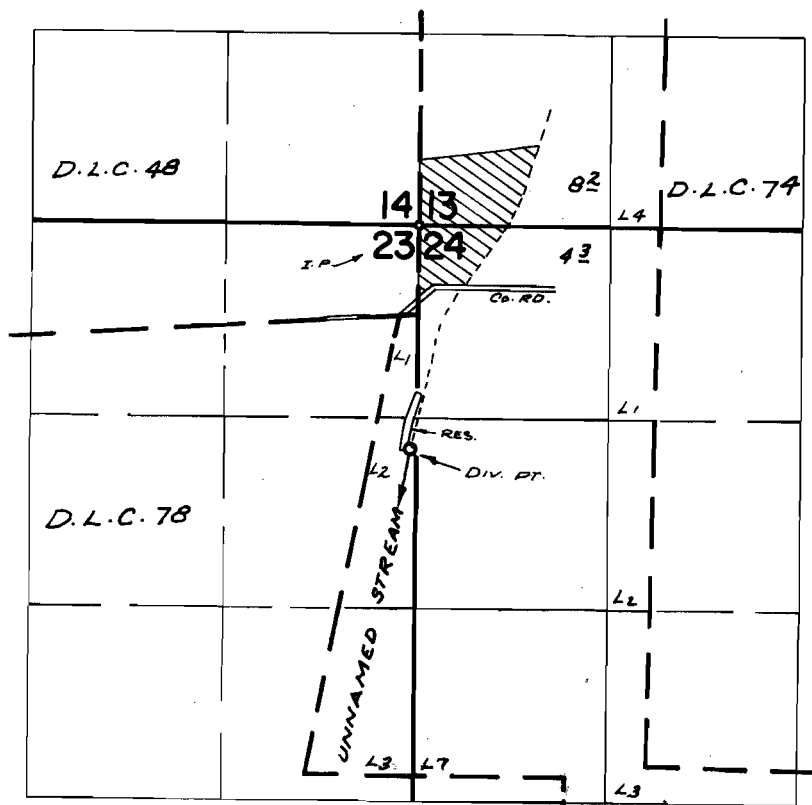

DIV. PT. LOC: 1530'S. & 40'W FROM N.E. COR. SEC. 23

FINAL PROOF SURVEY UNDER

Application No. 44653 Permit No. 33433
IN NAME OF

COUSSENS BROS.

Surveyed SEPT. 18, 1972, by R. MUCKEN