


T.2N.,R.4W.,W.M.

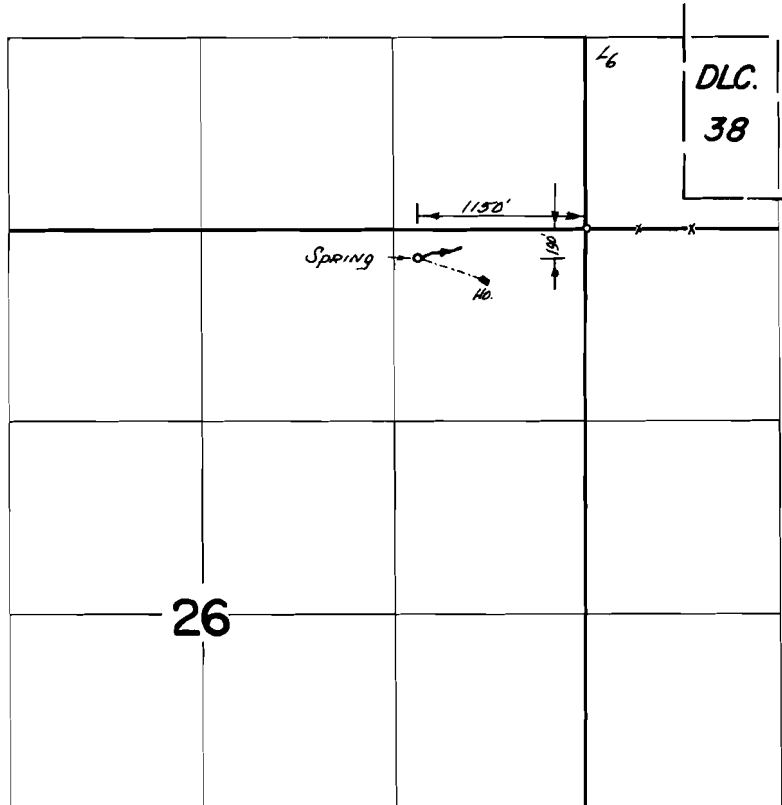

FINAL PROOF SURVEY
UNDER

Application No. 46337 Permit No. 34338
IN NAME OF

VIRGIL L. & SALLY B. BROADWATER

Surveyed JUNE 26 1973, by D. NOREY