


T.2N., R.4W., W.M.

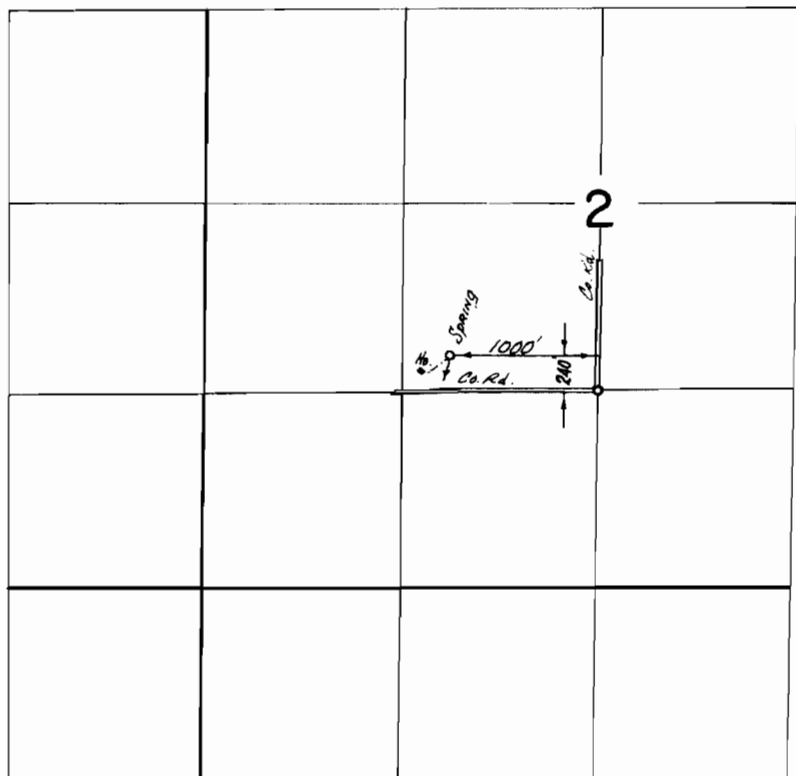

FINAL PROOF SURVEY
UNDER

Application No. 46655 Permit No. 34858
IN NAME OF

MARK T. & GLADYS L. CATTRON

Surveyed JUNE 27 1973, by D. NORBY