


T.2N.R.3W.W.M.

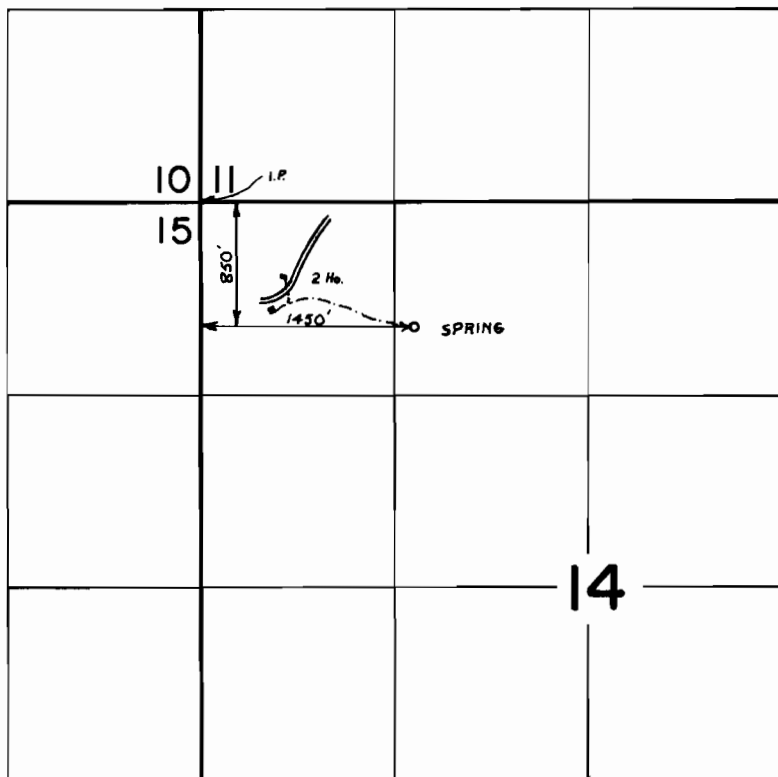

FINAL PROOF SURVEY
UNDER

Application No. 46831 Permit No. 35019
IN NAME OF

SAM & PATRICIA JOHNSON

Surveyed JUN 27 1973, by R.G. MUCKEN