


T. 1 N., R. 4 W., W.M.

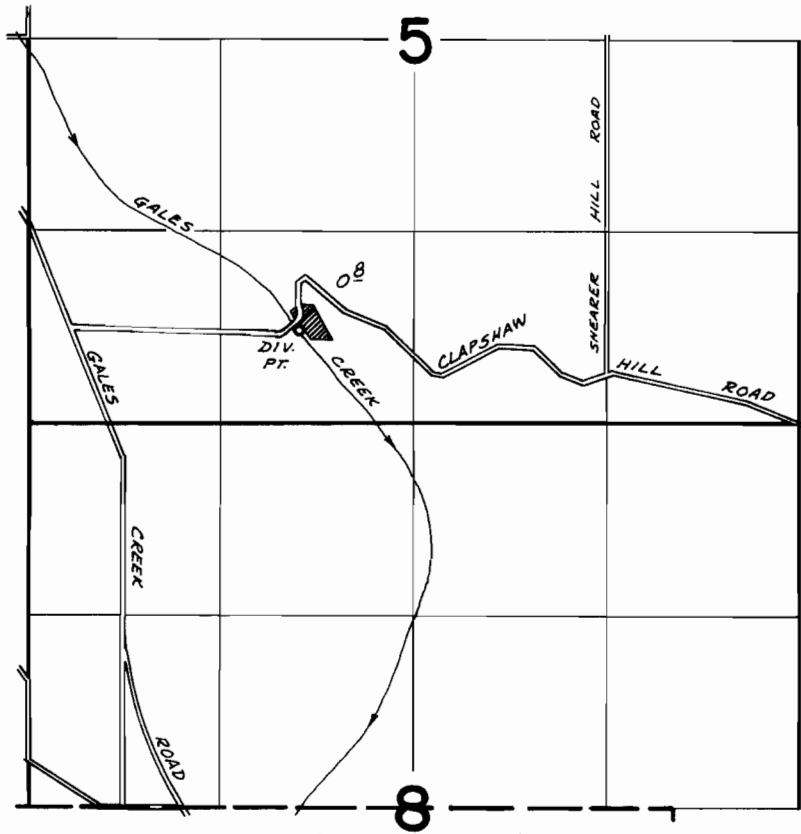

DIV. PT. LOCATED: 2000' S & 1850' E FROM W $\frac{1}{4}$ COR. SEC. 5.

FINAL PROOF SURVEY
UNDER

Application No. 47143 Permit No. 35296
IN NAME OF

LELAND H. CURRY

Surveyed June 8 1972, by L.E. Gould