


T.2N.,R.4W.,W.M.

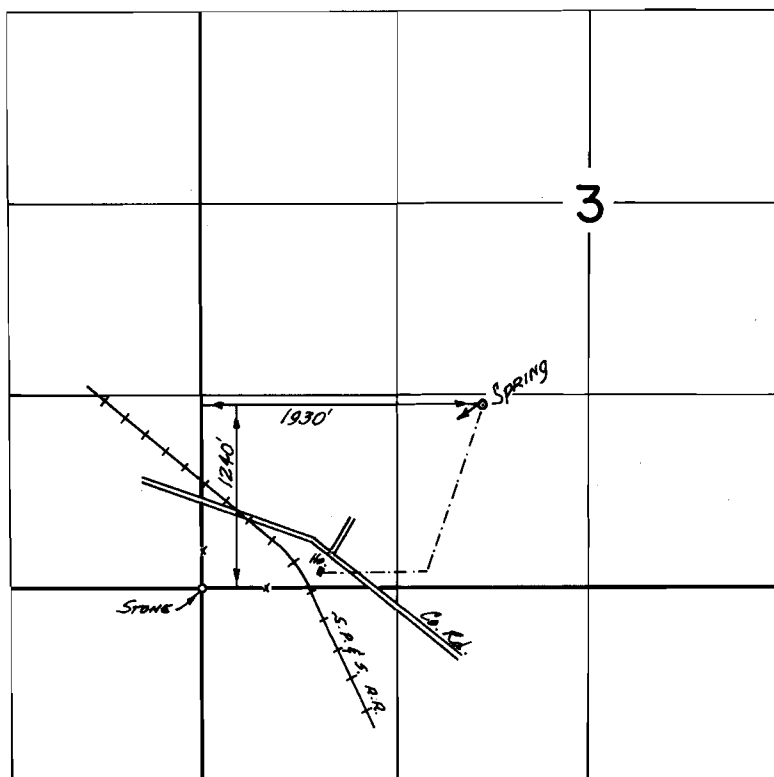

FINAL PROOF SURVEY
UNDER

Application No. 48199 Permit No. 35692
IN NAME OF

WILLIAM I. & BETTY ANN TOLKE

Surveyed JUNE 28 1973, by D. NORBY