T.4&5S.,R.3W.,W.M.

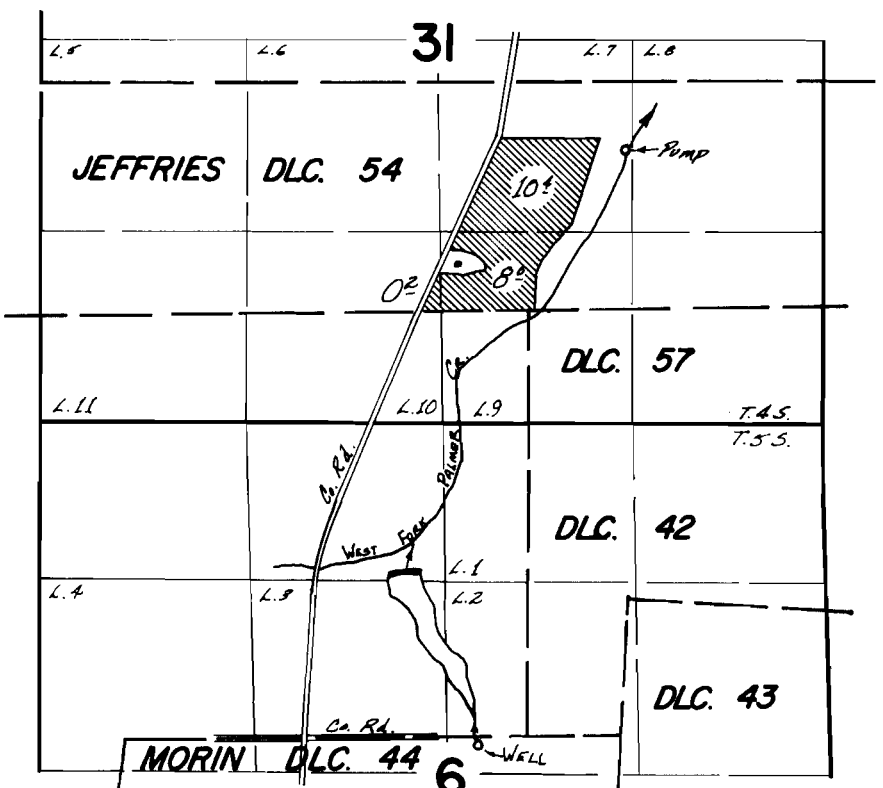

Well located 50' S. & 970' W. from NE cor. Morin DLC. 44

FINAL PROOF SURVEY

UNDER

Application No. G-4514 Permit No. G-3937

IN NAME OF

ROBERT H. OLHEISER

Surveyed May 18 19 73, by D. Norby

DEQ-ELL-10