


T.5S. R.4W. W.M.

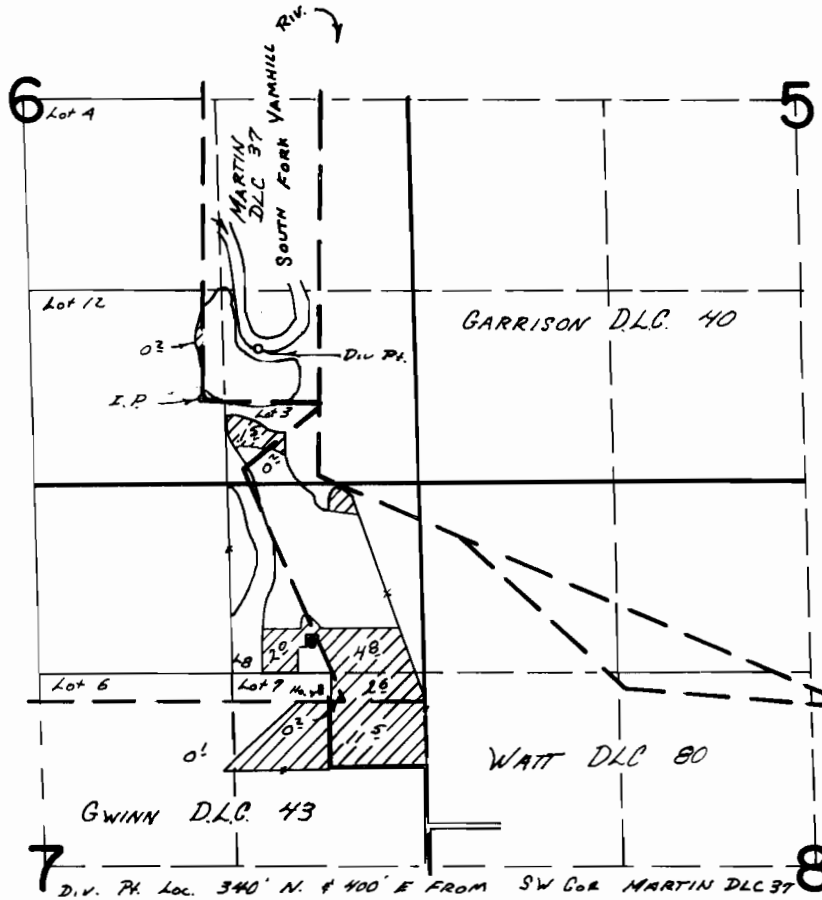

FINAL PROOF SURVEY
UNDER

Application No. 42221 Permit No. 31575
IN NAME OF

CHARLIE W. REED

Surveyed JUNE 1 1973, by R.G. MUCKEN