


T.5S., R.6W., W.M.

Handwritten notes:
D.L.C. 64
D.L.C. 70

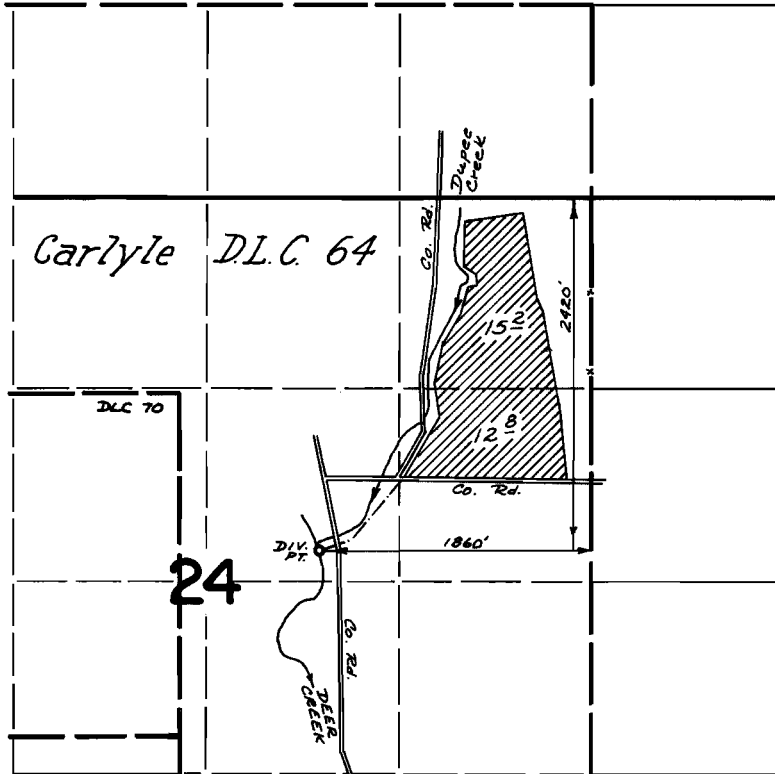

FINAL PROOF SURVEY UNDER

Application No. 44311 Permit No. 33091
IN NAME OF

JACOB GRAUER

Surveyed June 19 1972, by D. Norby