


T. 1 N. & 1 S. R. 38 E. W. M.

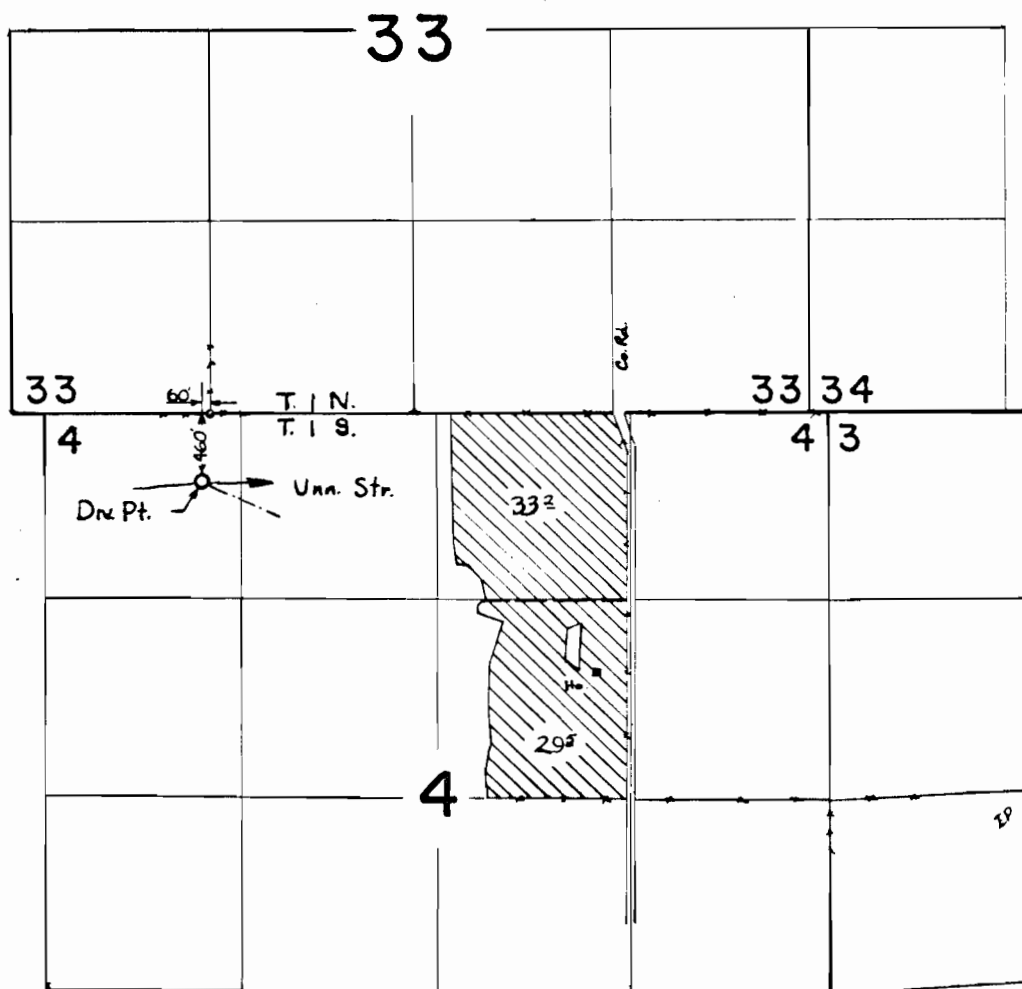

FINAL PROOF SURVEY
UNDER

TRANSFER B 207
Application No. 42030 Permit No. 31110
IN NAME OF

MAURICE D. BAKER

Surveyed 17 JULY 1969, by W. J. RUPPERT