
T. 7S.R.4 W. W.M.

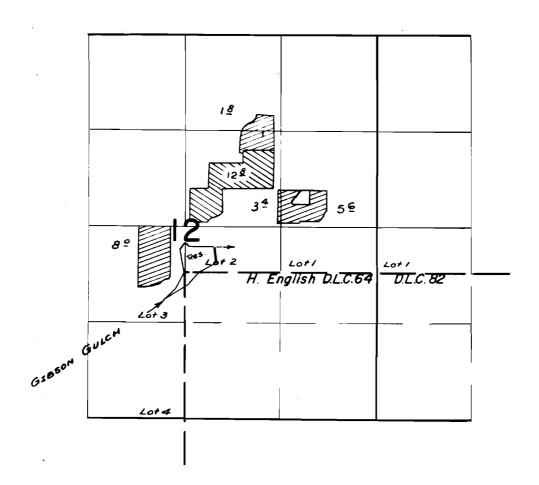

FINAL PROOF SURVEY

29901 23681 Application No. *P-29900* Permit No. *P-1763* IN NAME OF

REX, V.L., FRED & DUANE GIBSON

Surveyed 23 Mar 1961, by m. Bish

. 1961-**8** DFP-20-36