


T. 11S. R. 2W. W.M.

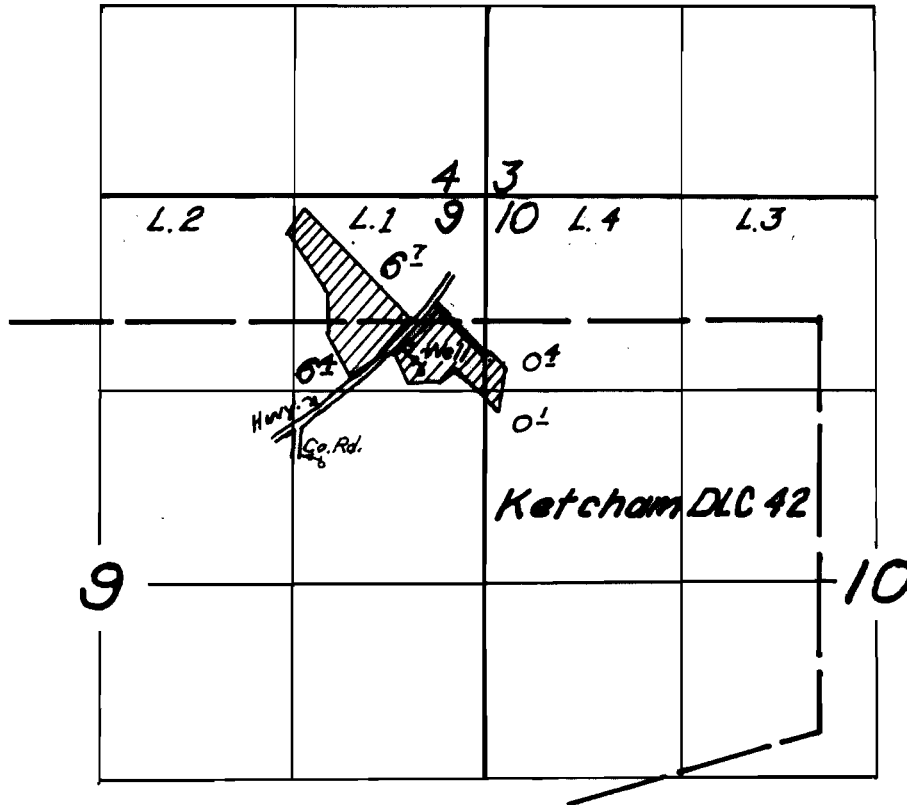

FINAL PROOF SURVEY
UNDER

Application No. *G-1090* ... Permit No. *G-1035*
IN NAME OF

Floyd Lander

Surveyed *29 Mar.* 1962, by *Carl R. Baker*