


T.8 & 9 S. R. 27 & 28 E. W.M.

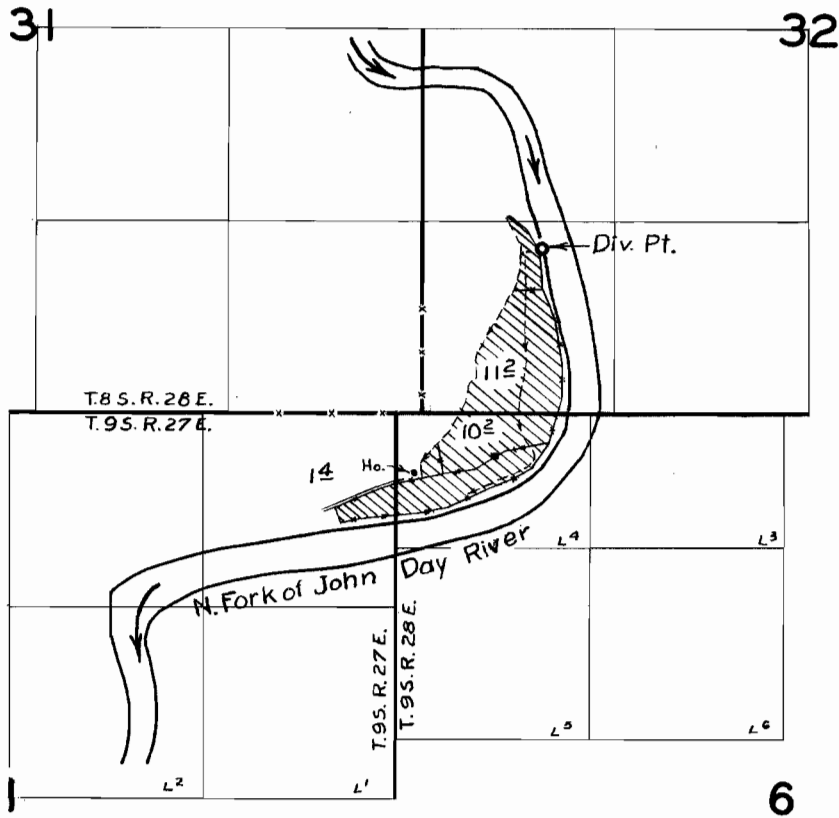

FINAL PROOF SURVEY UNDER

Application No. 188,355 Permit No. 144,720
IN NAME OF

J. M. Stubblefield

Surveyed 23 Sept., 1957, by M. B. Bish