


T. 3 S. R. 12 E. W. M.

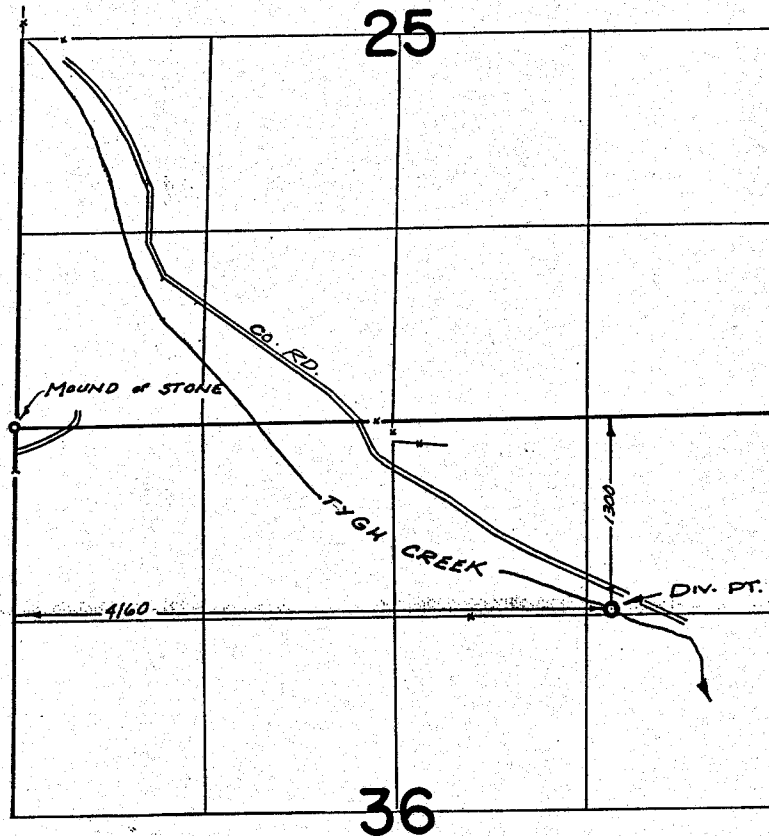

FINAL PROOF SURVEY
UNDER

TRANSFER No. P. 97
Application No. Permit No.
IN NAME OF

CLARENCE L. PHILLIS

Surveyed *Map 2*, 1971, by *R. MUCKEN*