


T.10S.R.5W.W.M.

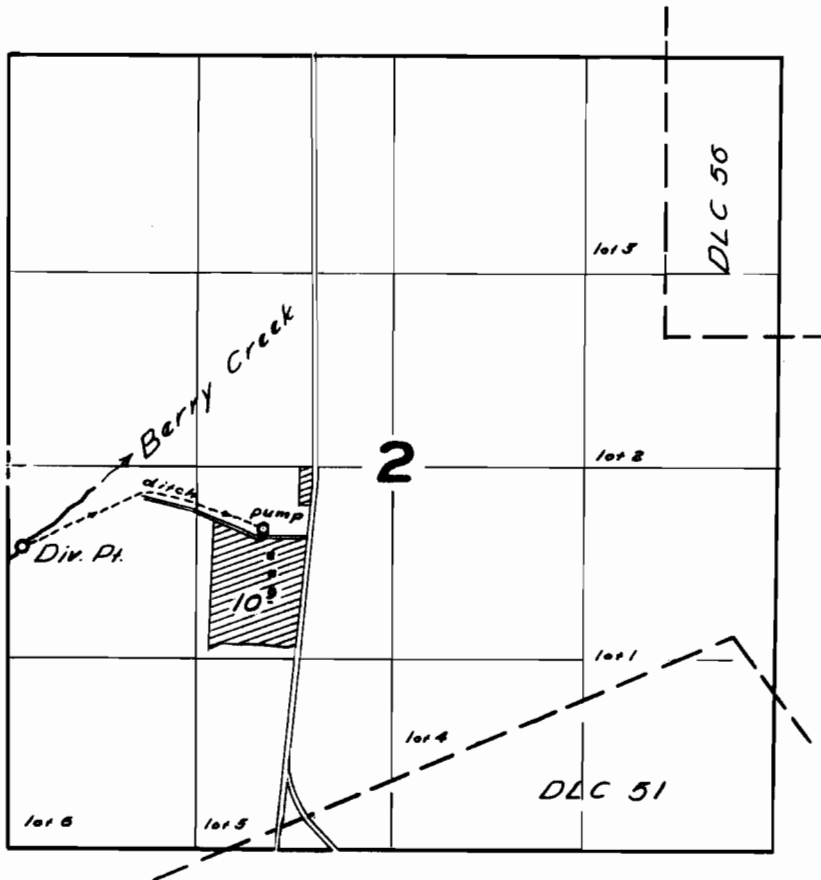

FINAL PROOF SURVEY
UNDER

Application No. 23319 Permit No. 18559
IN NAME OF

RALPH KESTER

Surveyed 31 July 1957, by [Signature]