


T.4S., R.1E., W.M.

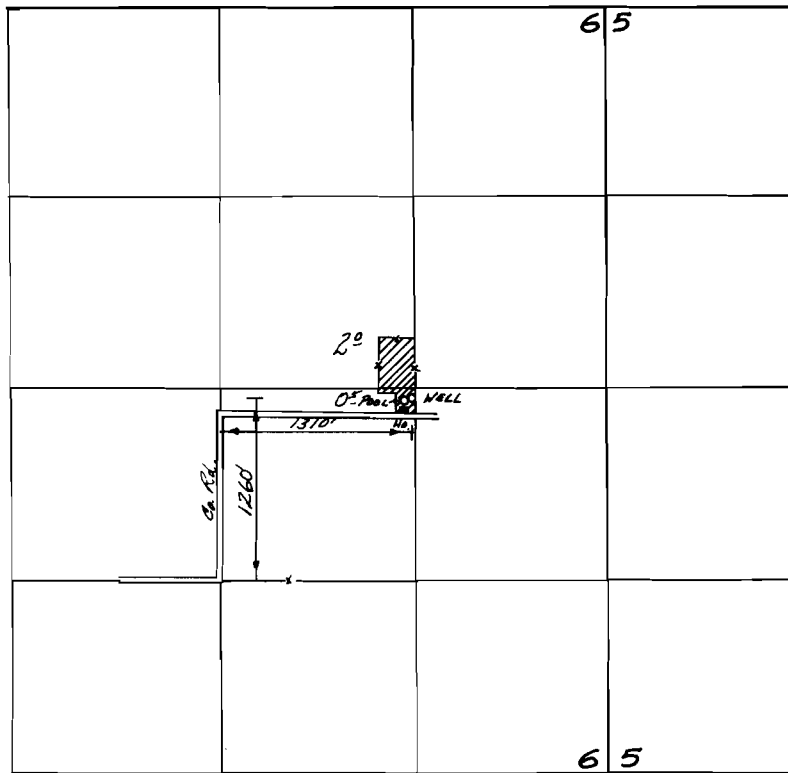

**FINAL PROOF SURVEY**  
UNDER

Application No. G-4416 Permit No. G-4162  
IN NAME OF

HAROLD & LAURA HAGMAN

Surveyed July 30 1973, by D. NORBY