


T. 3 S. R. 1 E. W. M.

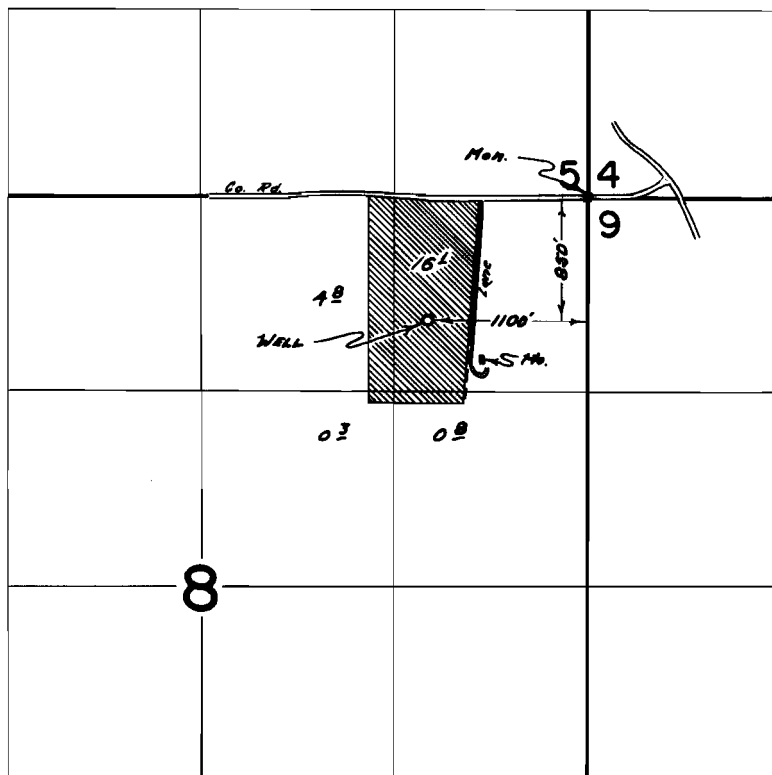

FINAL PROOF SURVEY
UNDER

Application No. B-5601 Permit No. B-4916
IN NAME OF

V. L. NASH

Surveyed SEP. 11 1978, by R. A. MUCKEN