


T.4S., R.1E., W.M.

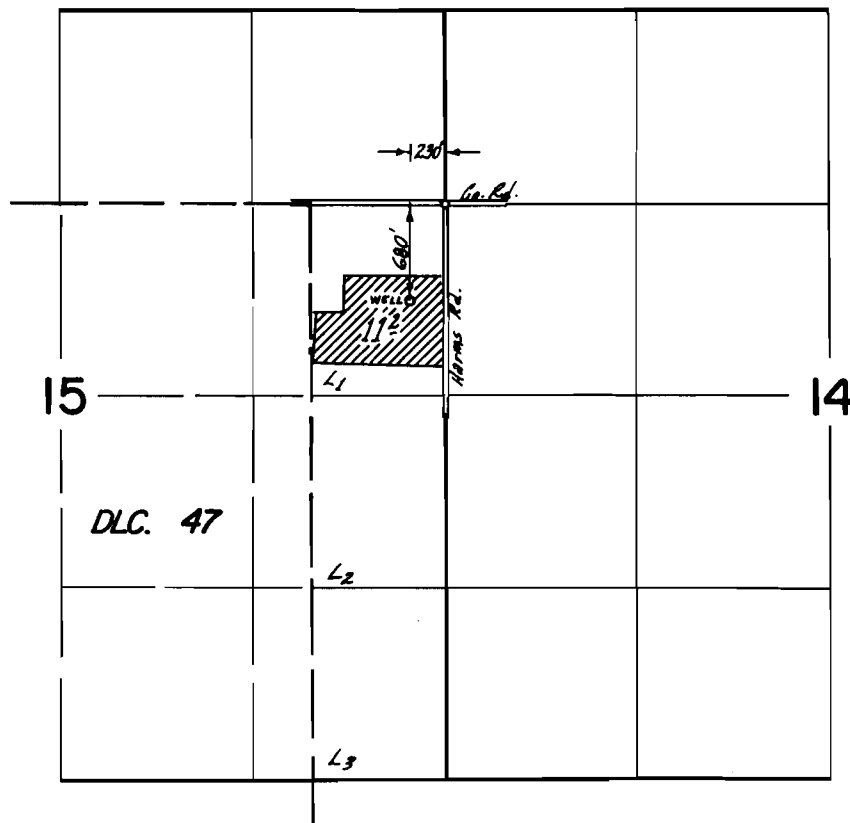

FINAL PROOF SURVEY
UNDER

Application No. G-5887 Permit No. G-5037
IN NAME OF

CONSTANTIN & JUDITH ETINGER

Surveyed Aug. 1 1973, by D. NORBY