


T. 3S., R. 1E., W.M.

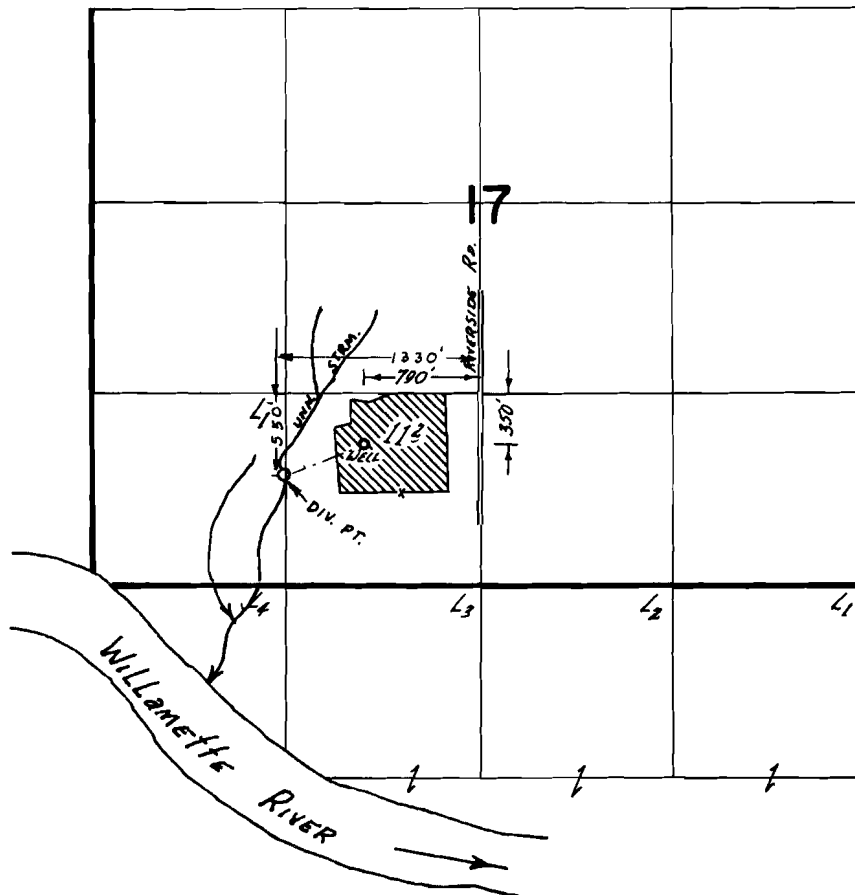

FINAL PROOF SURVEY
UNDER

Application No. ⁴⁷²¹² ~~G-5247~~ Permit No. ³⁵³⁶⁵ ~~G-5102~~
IN NAME OF

EARL BRUCK

Surveyed Aug. 3 1973 by D. Norey
OCT 7 74 L. H. NUNN