


T.2&3S. R.5E. W.M.

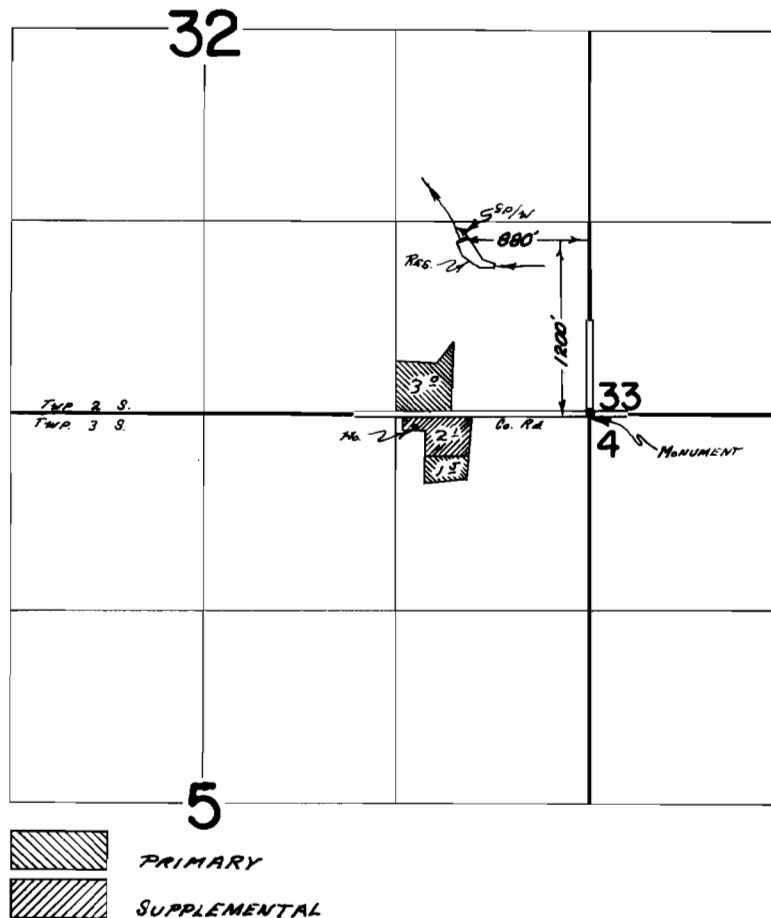

FINAL PROOF SURVEY
UNDER

Transfer No. U-12
Application No. R-44954 Permit No. R-5307
44955 33601
IN NAME OF

CLYDE UPDEGRAVE

Surveyed MAY 23 1972, by R. B. MCKEN