


T.3S.,R.28&3E.,W.M.

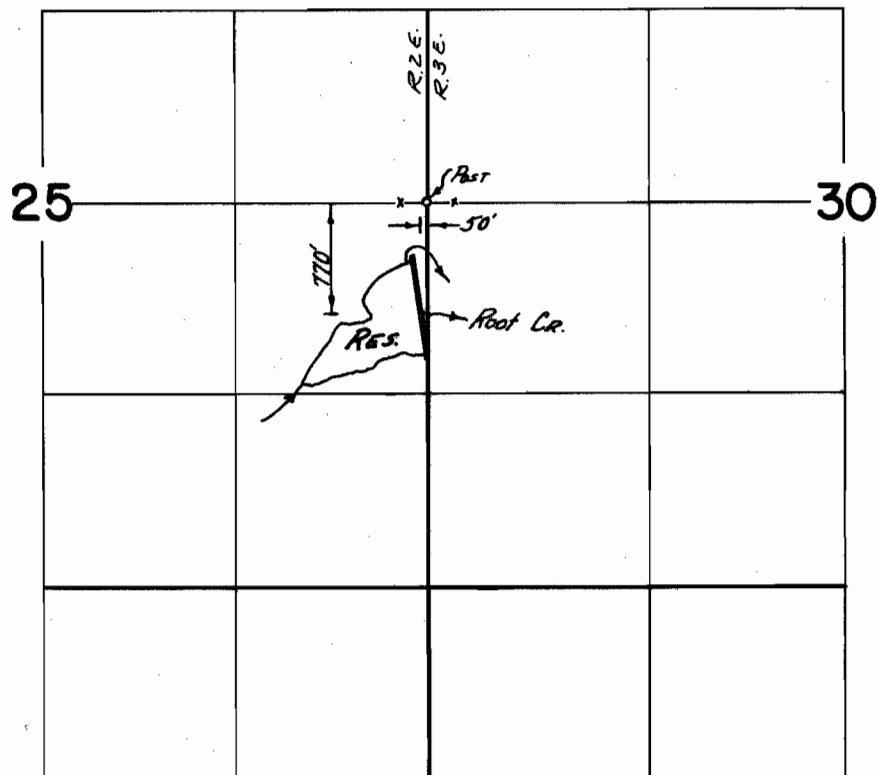

FINAL PROOF SURVEY
UNDER

R-47445 R-5586
Application No. 47446 Permit No. 34890
IN NAME OF
PHIL SNYDER

Surveyed Aug. 2 1973, by D. Nobby