


T.4S., R.4E., W.M.

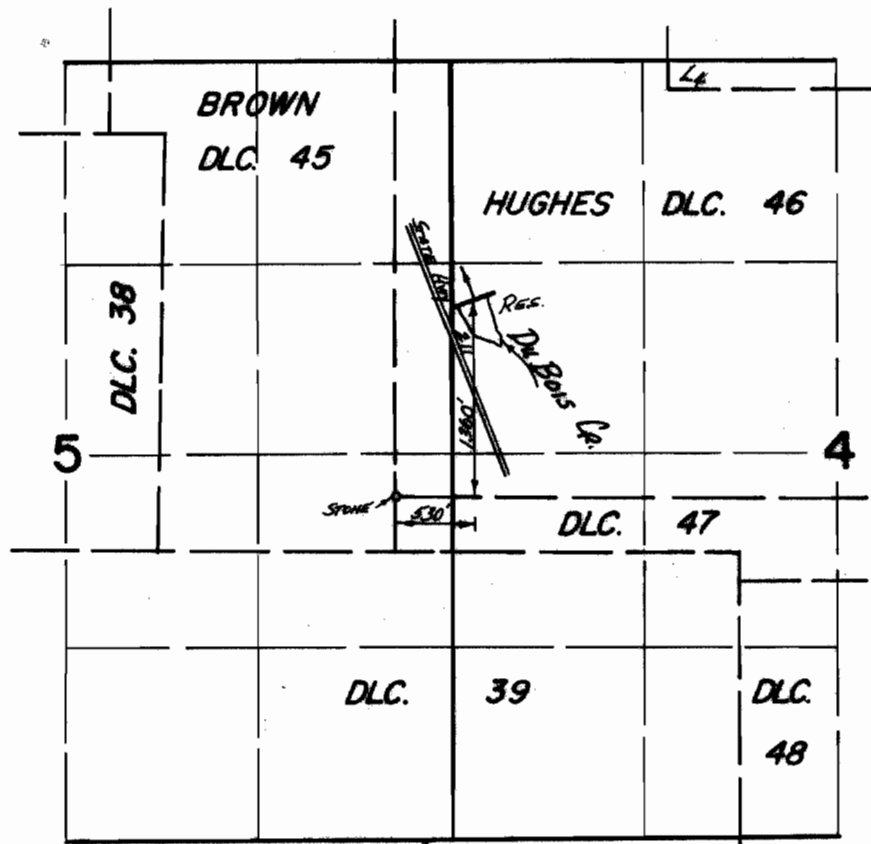

FINAL PROOF SURVEY
UNDER

R-47113 R-5658
Application No. 47114 Permit No. 35277
IN NAME OF
RAY KOZERA

Surveyed Aug. 1 1973, by D. NORBY