


T. 2S. R. 5E. W.M.

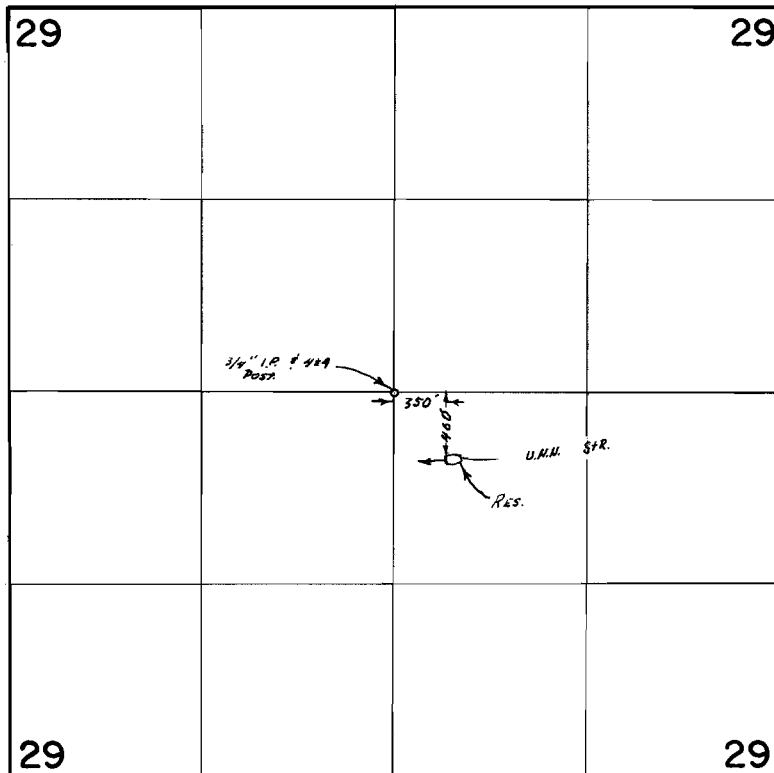

FINAL PROOF SURVEY
UNDER

Application No. R. 47869 Permit No. R. 5685
IN NAME OF

MARTIN J. REEDY

Surveyed MAY 25 1972, by R. G. MUCKEN