


T.2S. R.5E. W.M.

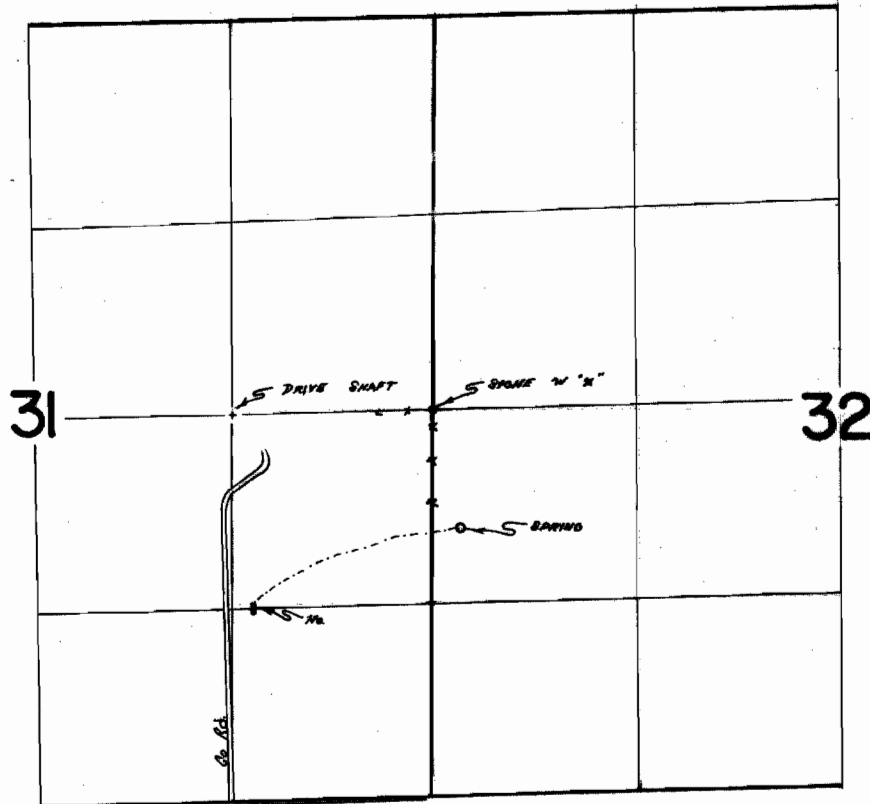

SPRING Loc: 810' S & 190' E FROM N 1/4 Cor. Sec. 32

FINAL PROOF SURVEY
UNDER

Application No. 17235 Permit No. 34994
IN NAME OF

RUSSELL L. SHEERMAN

Surveyed MAY 22 1922, by P. B. MCKEN