


T.2S. R.5E. W.M.

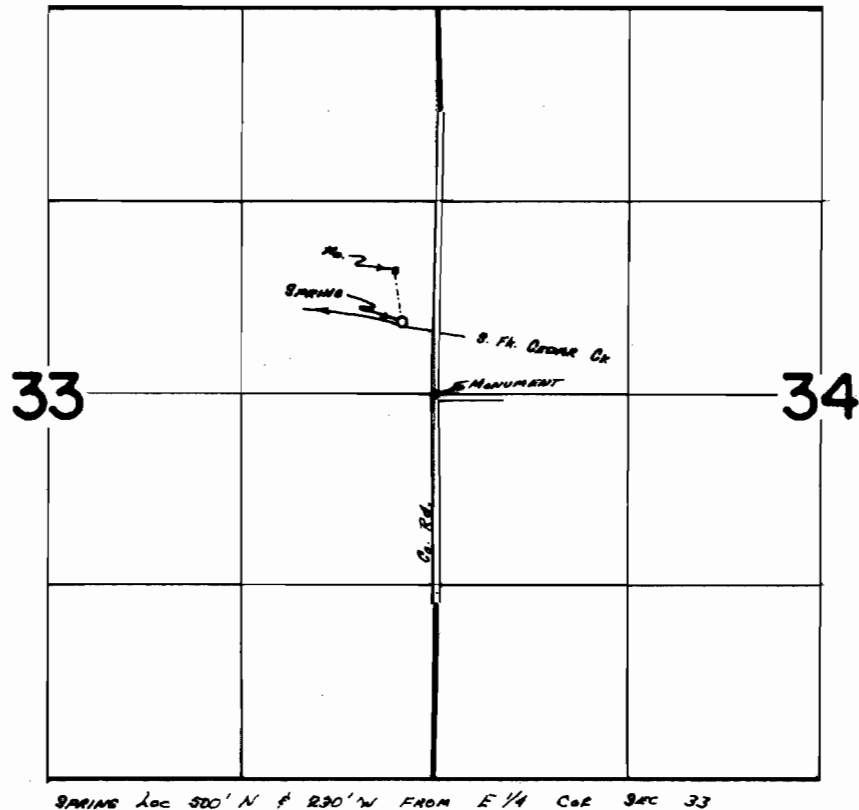

FINAL PROOF SURVEY
UNDER

Application No. 17,982 Permit No. 35,451
IN NAME OF

HALLIE M. BAUER

Surveyed MAY 25 1972, by R. R. MUGGERY