


T.2S. R.6E. W.M.

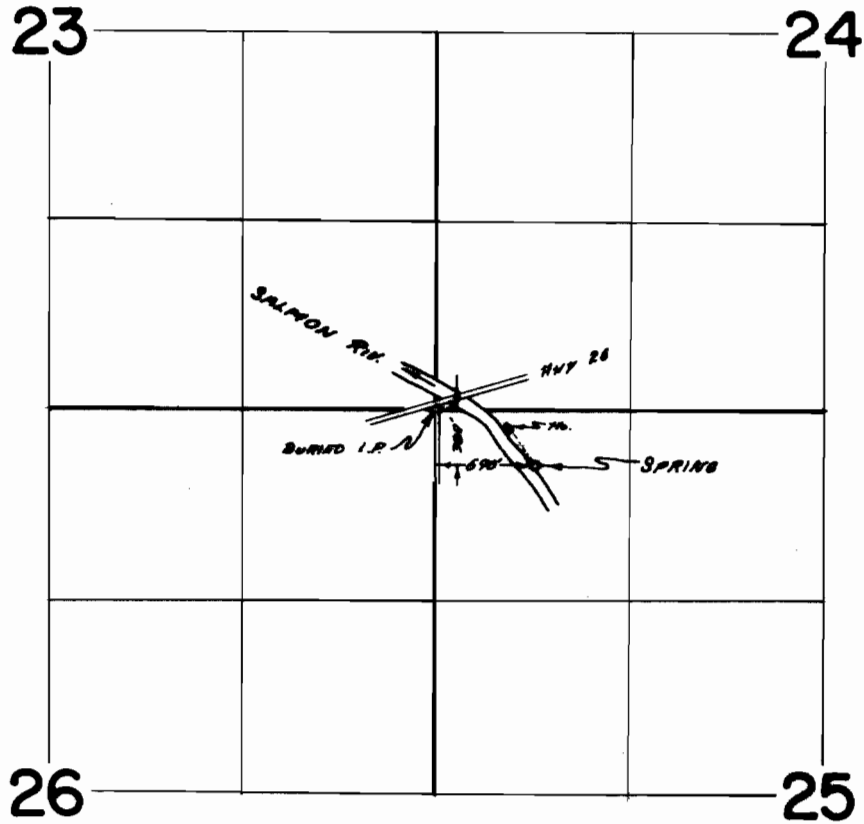

FINAL PROOF SURVEY
UNDER

Application No. 177685 Permit No. 35878
IN NAME OF

DARRELL A. WROTEN

Surveyed May 24 1972, by R. B. MUGGER