


T.4S., R.1E., W.M.

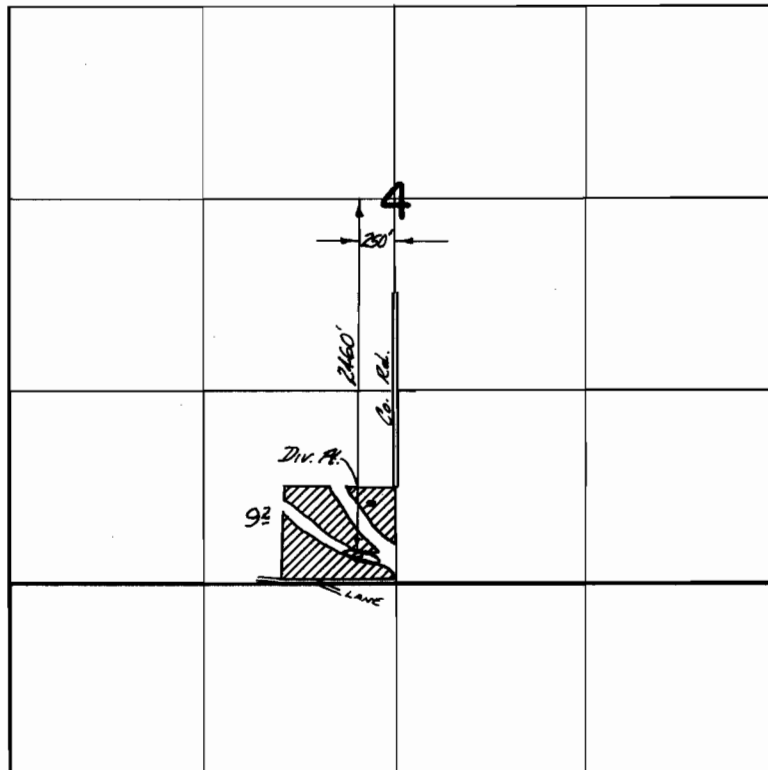

**FINAL PROOF SURVEY**  
UNDER

Application No. 47868 Permit No. 35873  
IN NAME OF

A. D. NELSON

Surveyed July 31 1973, by D. Norby