


T.35&36S.R.14&15E.W.M.

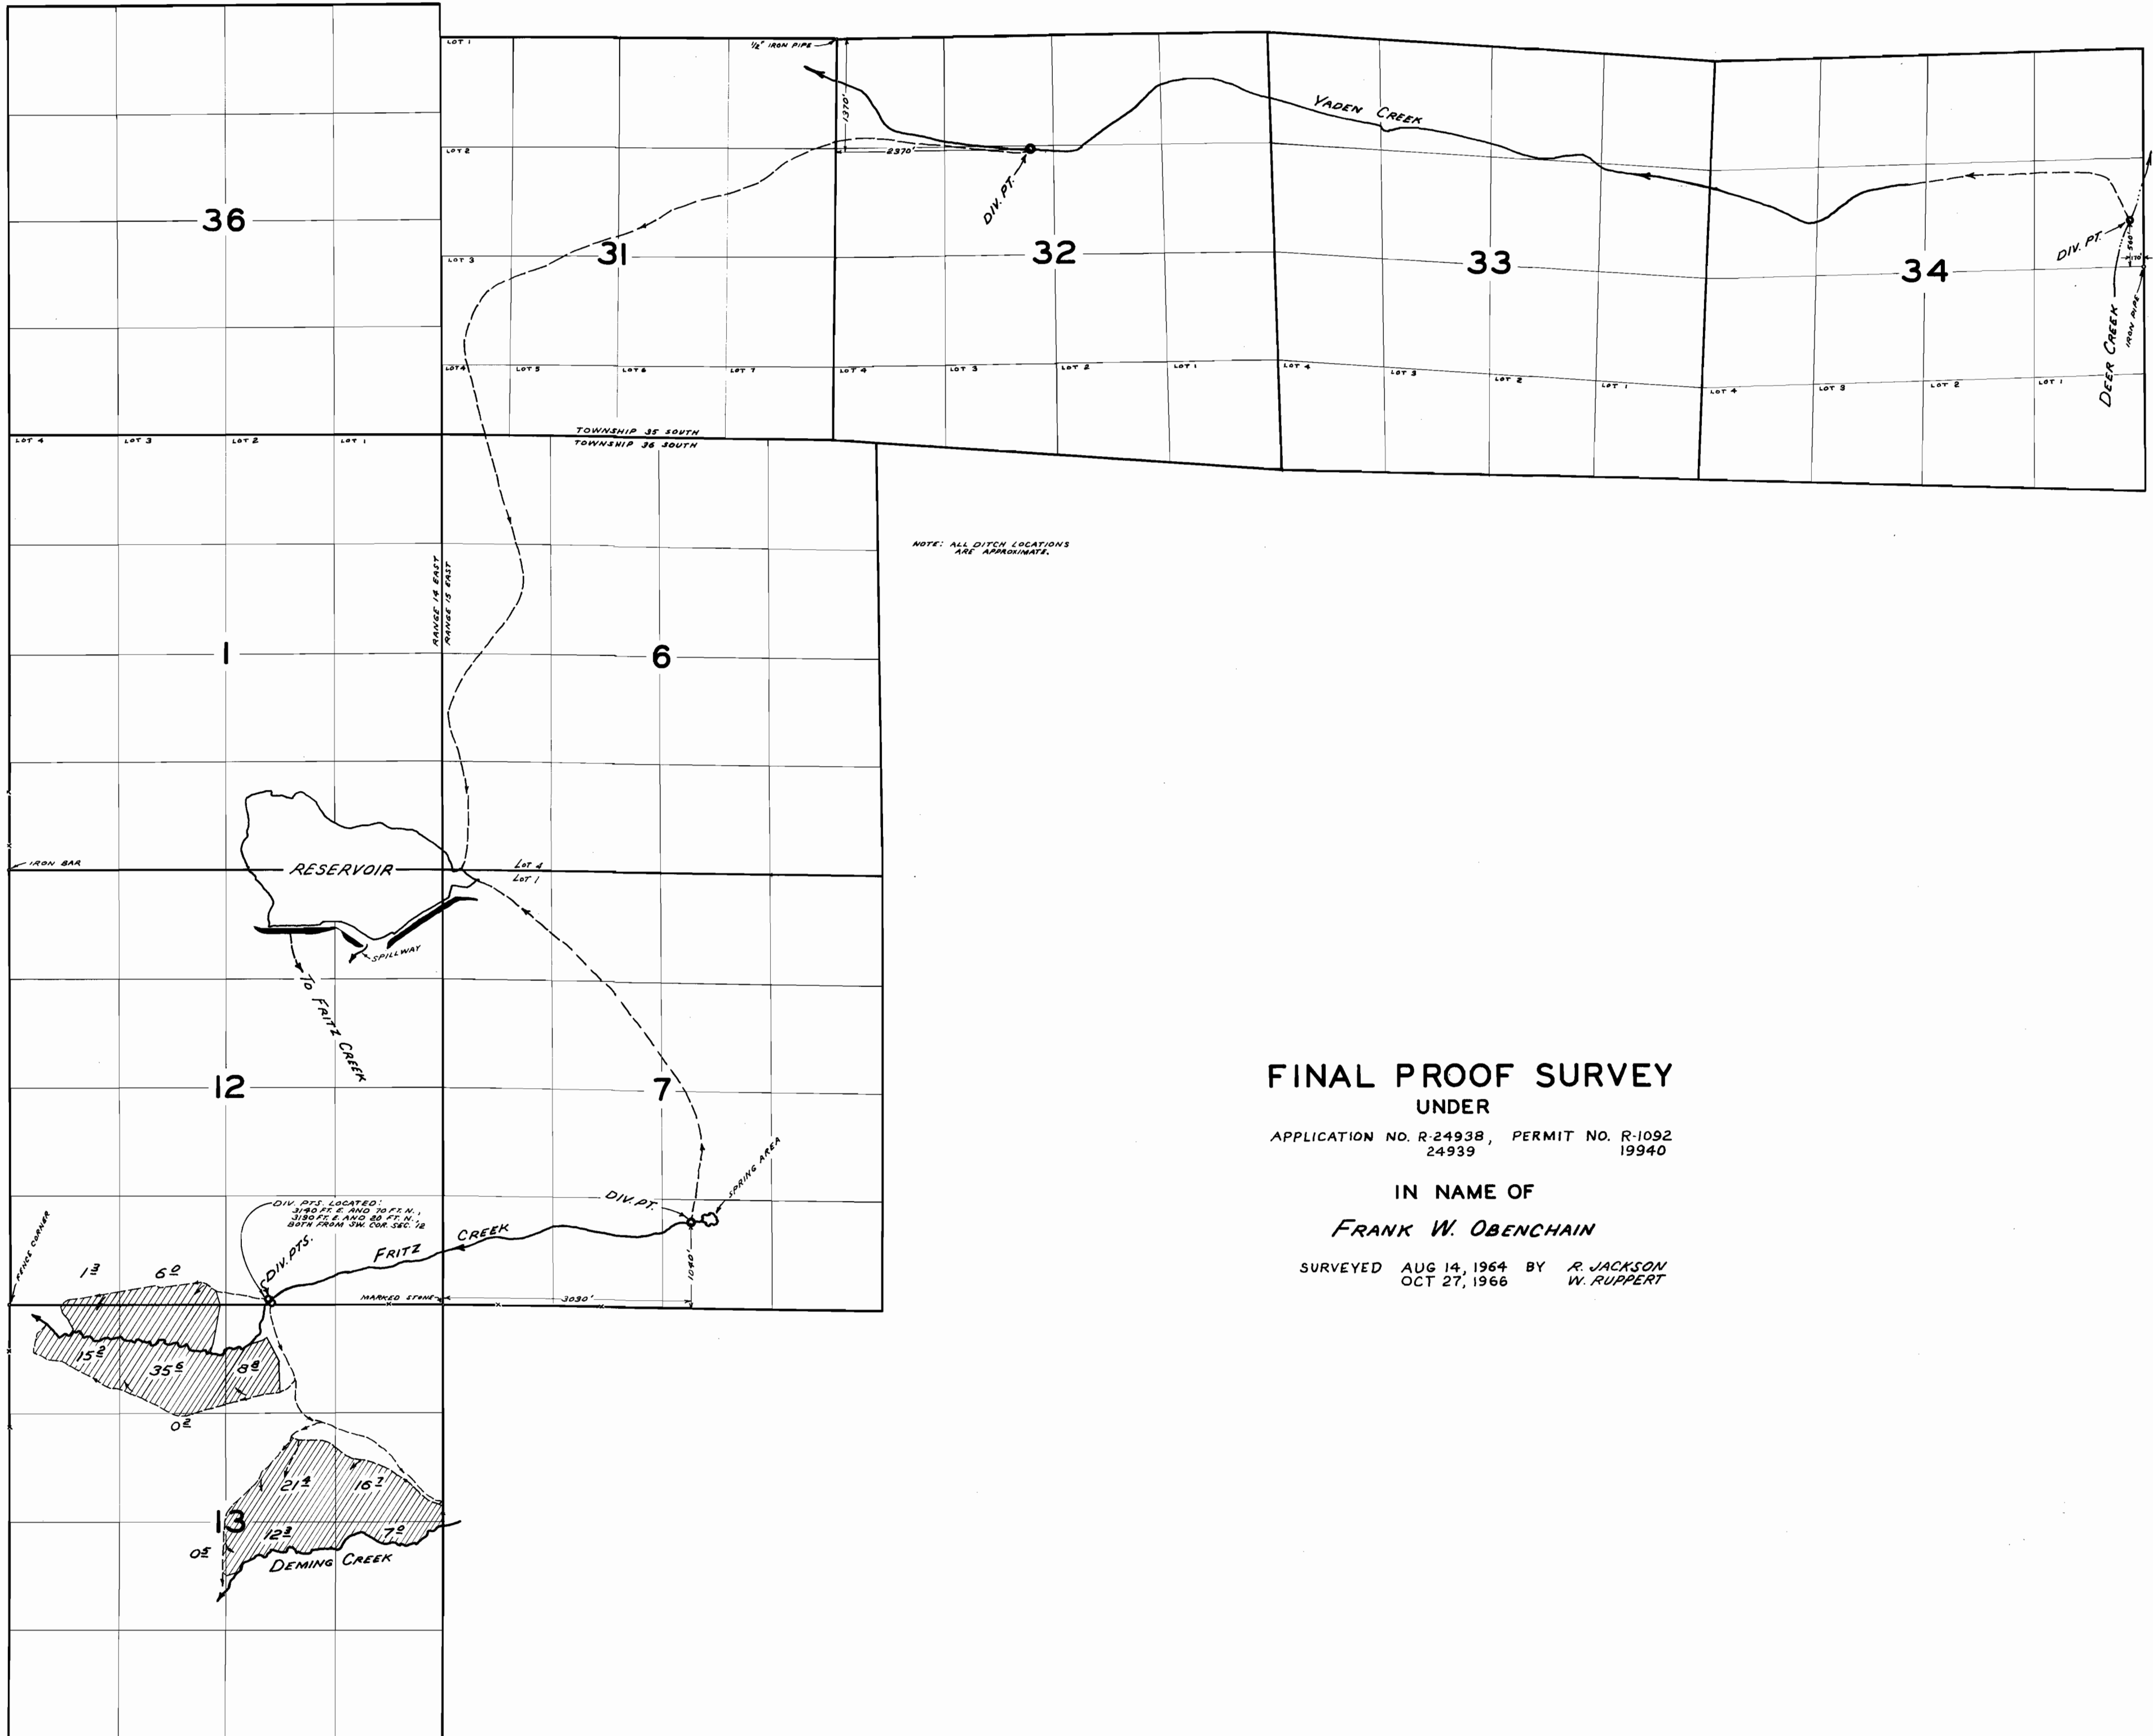

NOTE: ALL DITCH LOCATIONS ARE APPROXIMATE.

FINAL PROOF SURVEY

UNDER

APPLICATION NO. R-24938, PERMIT NO. R-1092
24939 19940

IN NAME OF

FRANK W. OBENCHAIN

SURVEYED AUG 14, 1964 BY R. JACKSON
OCT 27, 1966 W. RUPPERT