

P-7114-1
Nov. 1965

UNITED STATES
DEPARTMENT OF THE INTERIOR
BUREAU OF LAND MANAGEMENT

34169
40662


SECTION

31

Oregon State Water Filings

TOWNSHIP 40S, RANGE 15E, W. M.

North

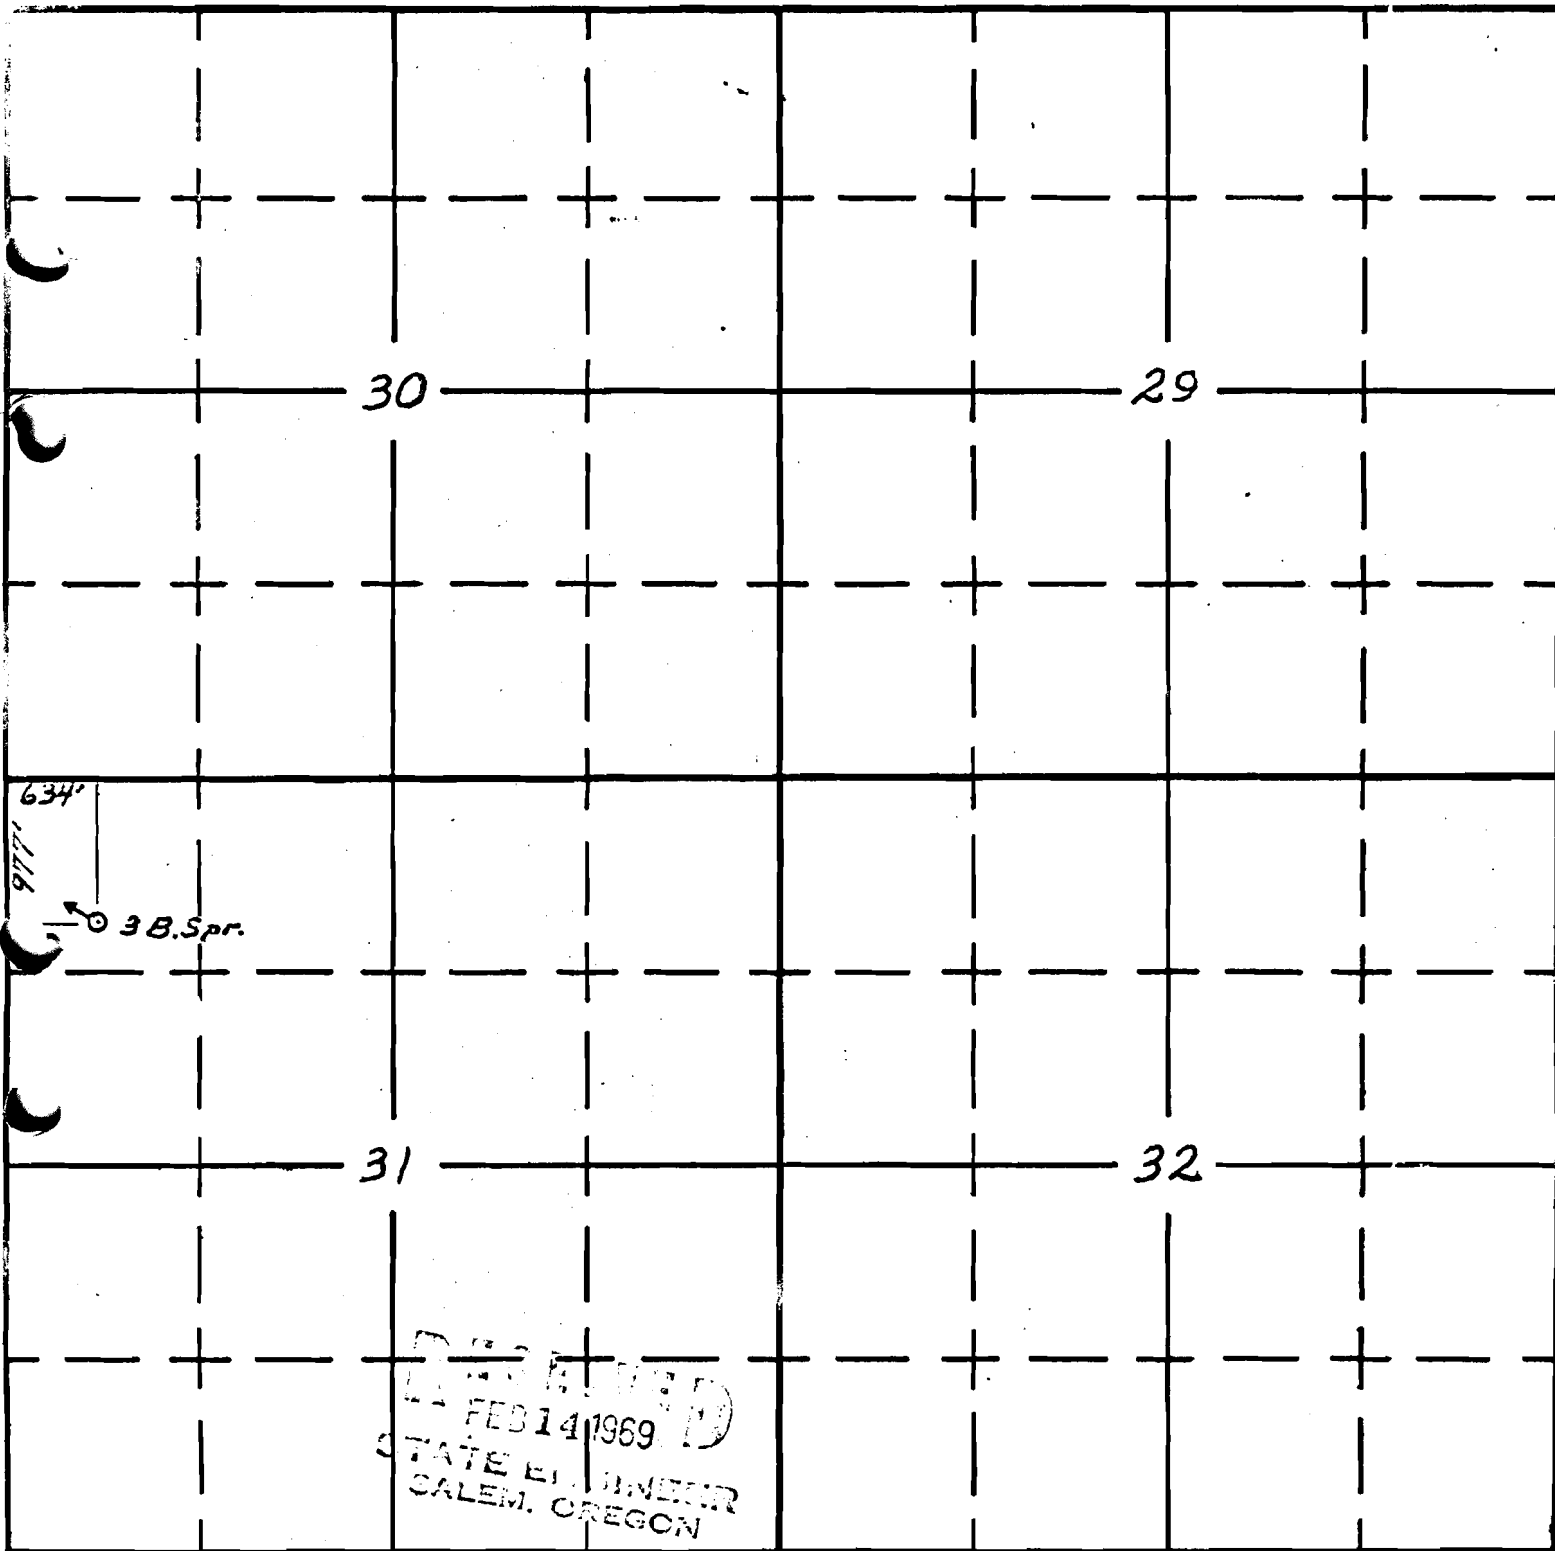

East Branch Lick Rv. Misc

South

APPLICATION No. 45774
PERMIT No. 34169