

Form AI-187
March 1961

UNITED STATES
DEPARTMENT OF THE INTERIOR
BUREAU OF LAND MANAGEMENT


34171
40663

SECTION 25

Oregon State Water Filings

TOWNSHIP 39 S, RANGE 13 E, W. M.

North

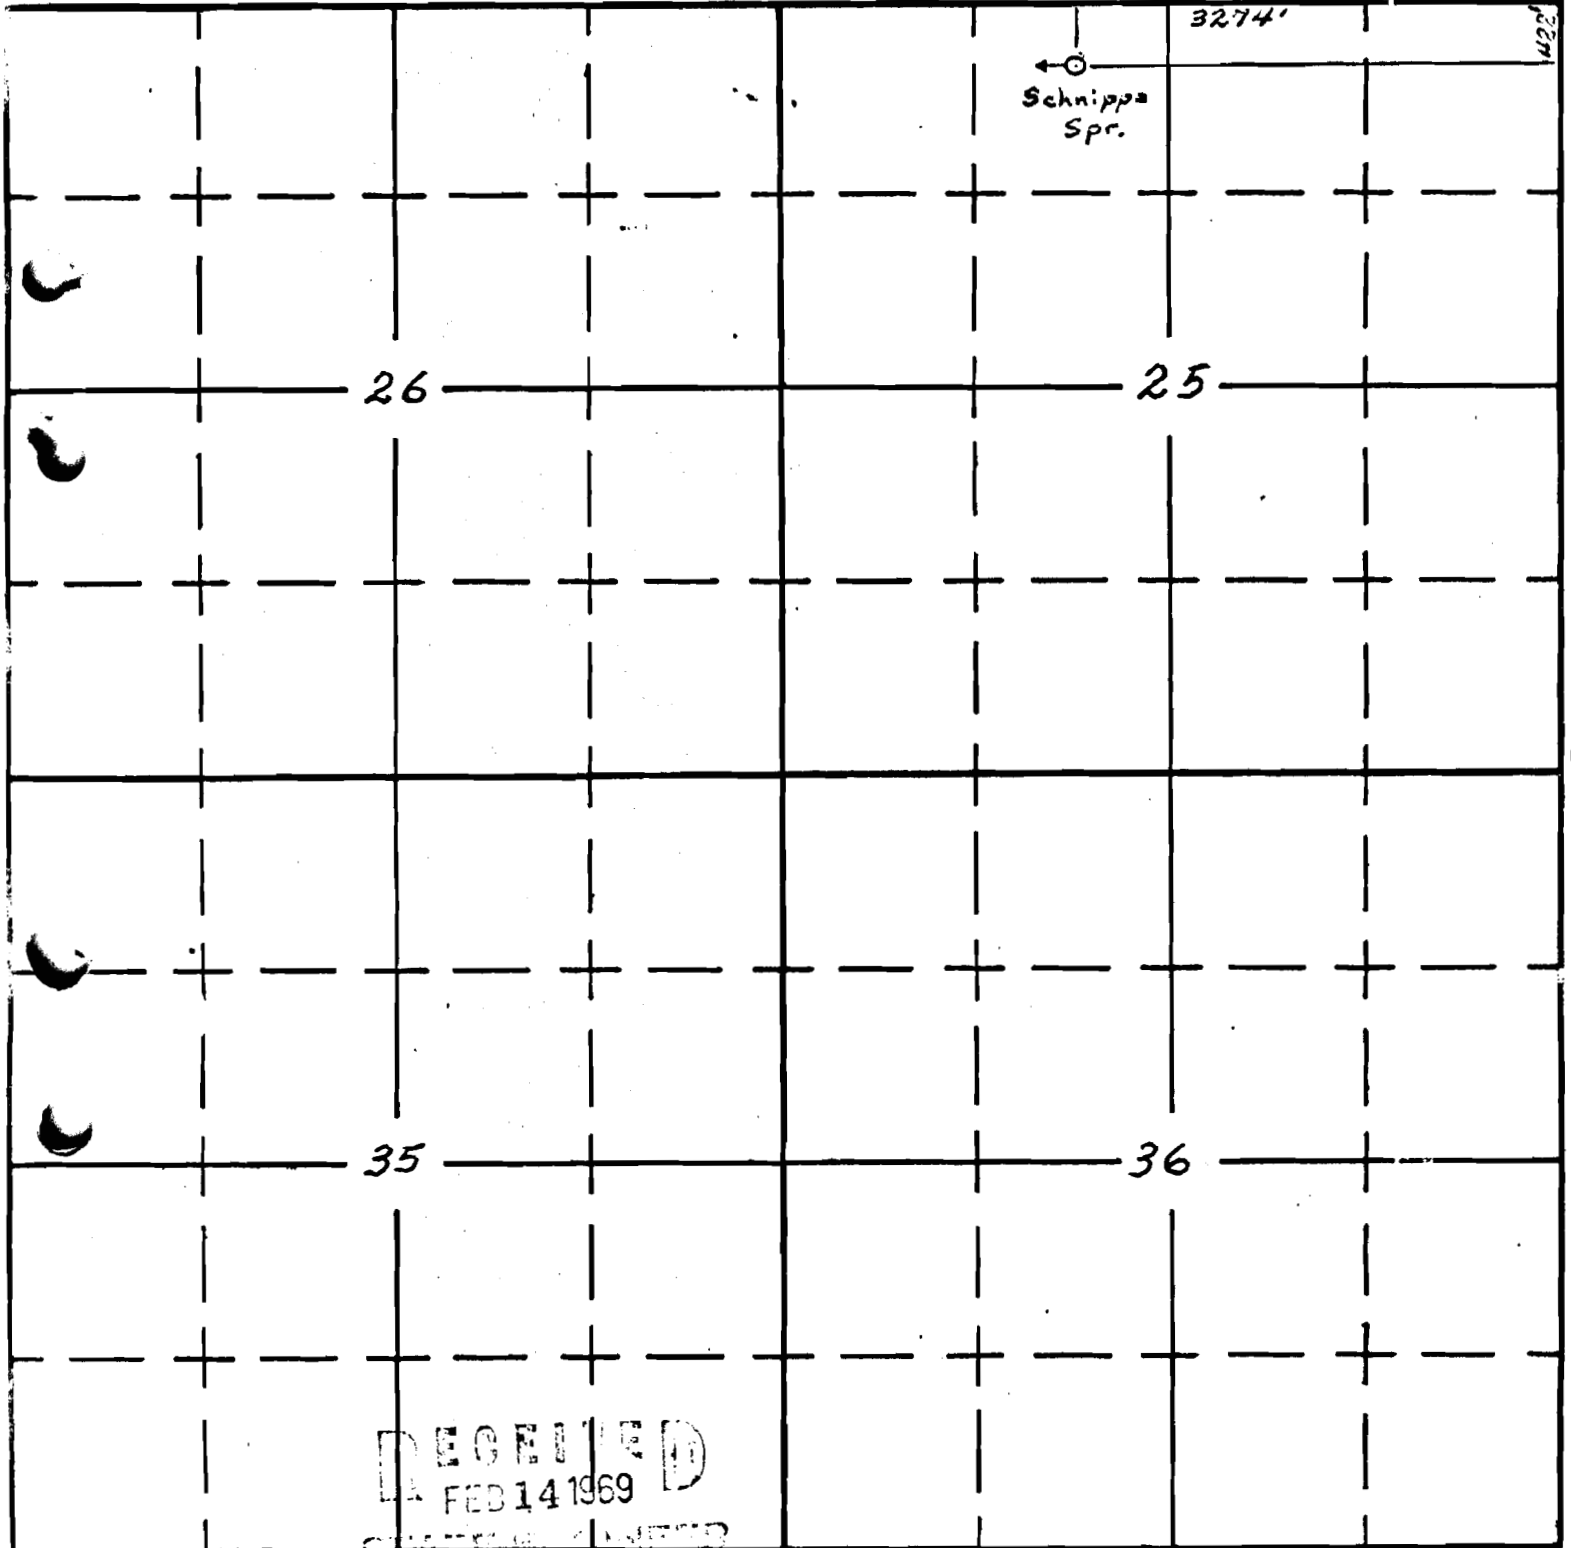

RECEIVED
FEB 14 1969
SALEM, OREGON

South

Mulla Ch. & Mac.

APPLICATION No. 45776
PERMIT No. 34171