

P-7114-1
Nov. 1965

UNITED STATES
DEPARTMENT OF THE INTERIOR
BUREAU OF LAND MANAGEMENT


34173
40665

SECTION
35

Oregon State Water Filings

TOWNSHIP 38S, RANGE 13E, W. M.

North

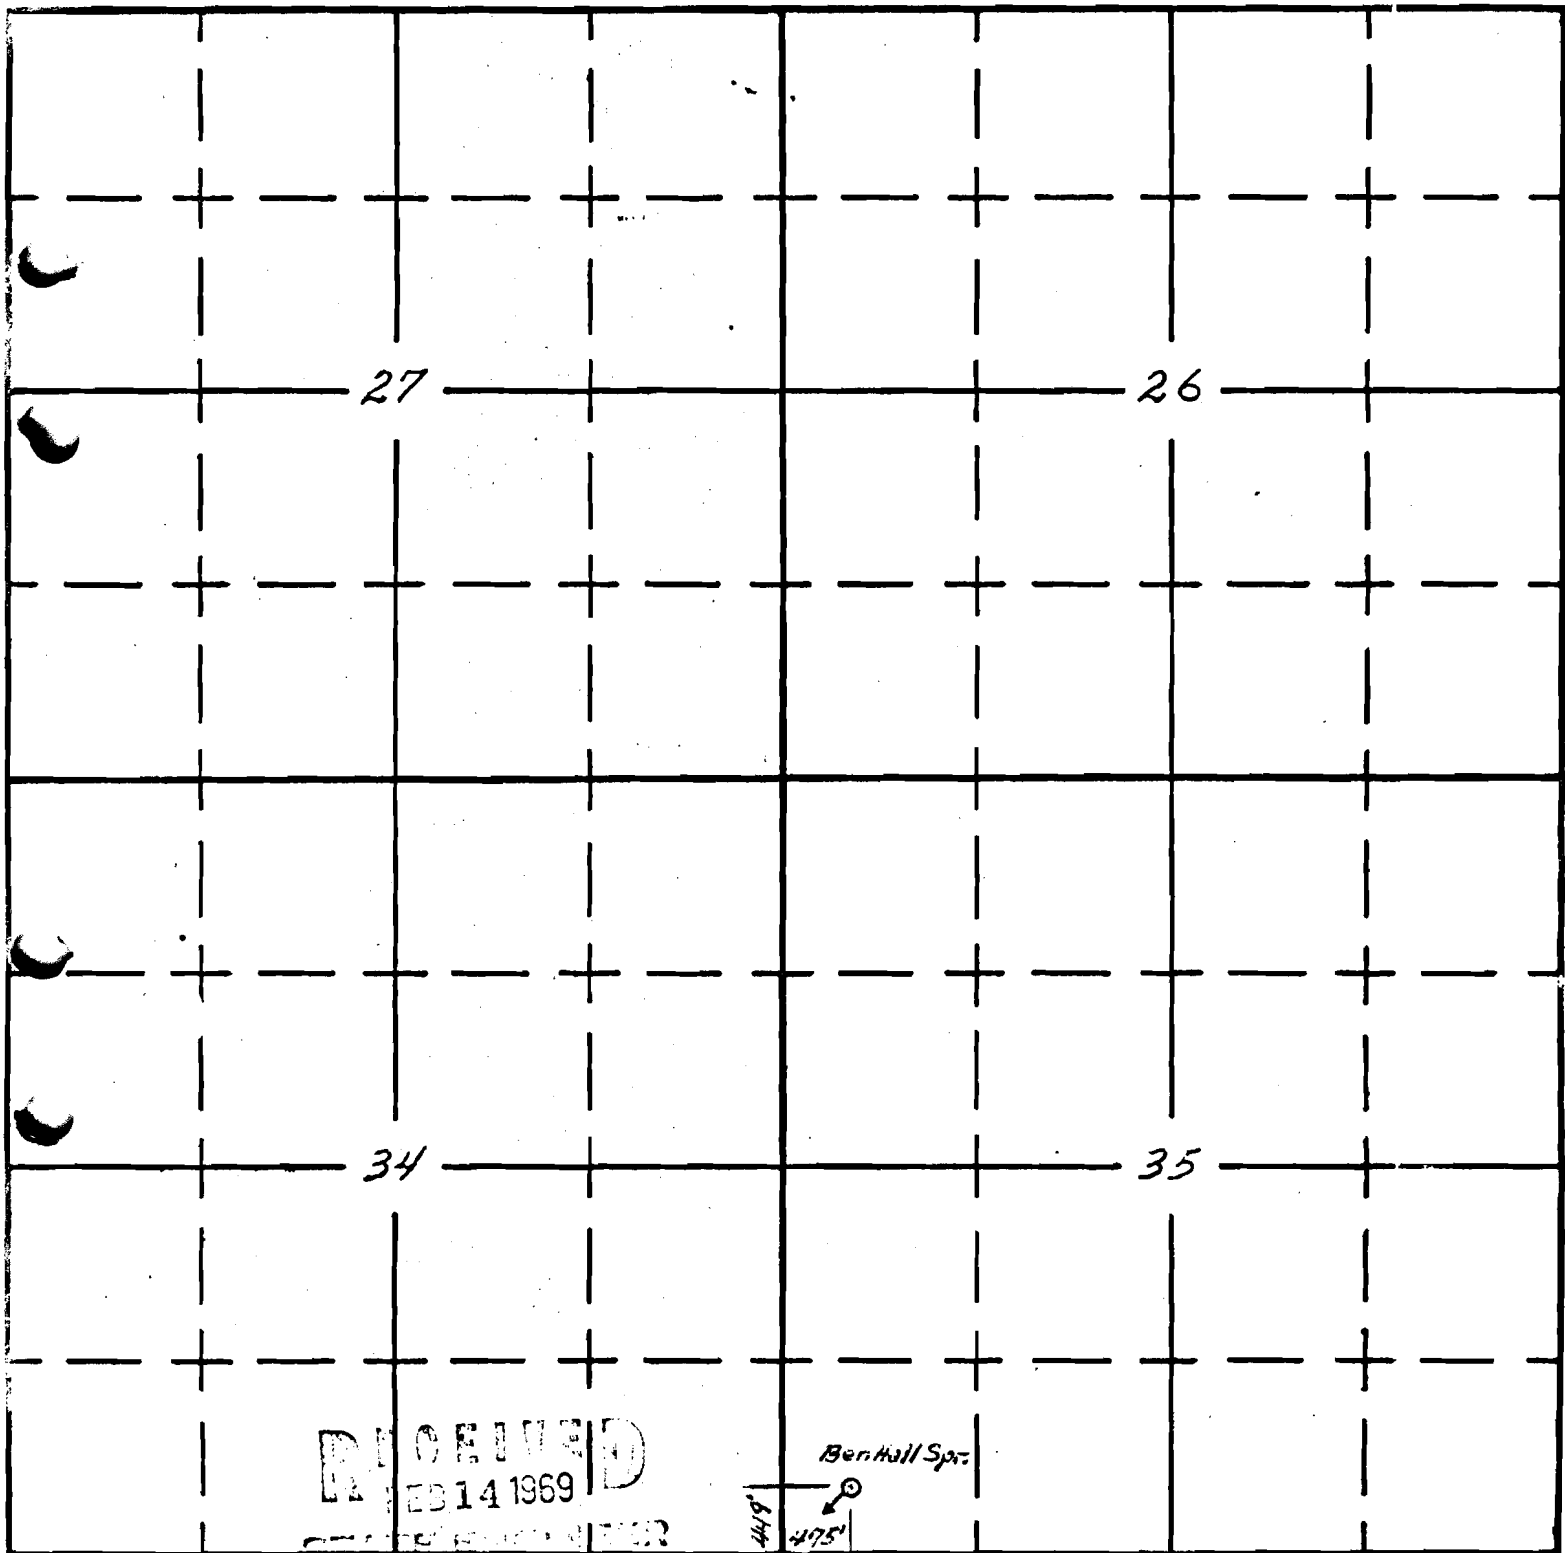

RECEIVED
FEB 14 1969

SALEM, OREGON

Ben Hall Spr.

449'
475'

South

Mike Cole: Mac

APPLICATION No. 45778
PERMIT No. 34173