

1965

UNITED STATES
DEPARTMENT OF THE INTERIOR
BUREAU OF LAND MANAGEMENT


34285
40666p

SECTION

13

Oregon State Water Filings

TOWNSHIP 39S., RANGE 14E., W. M.

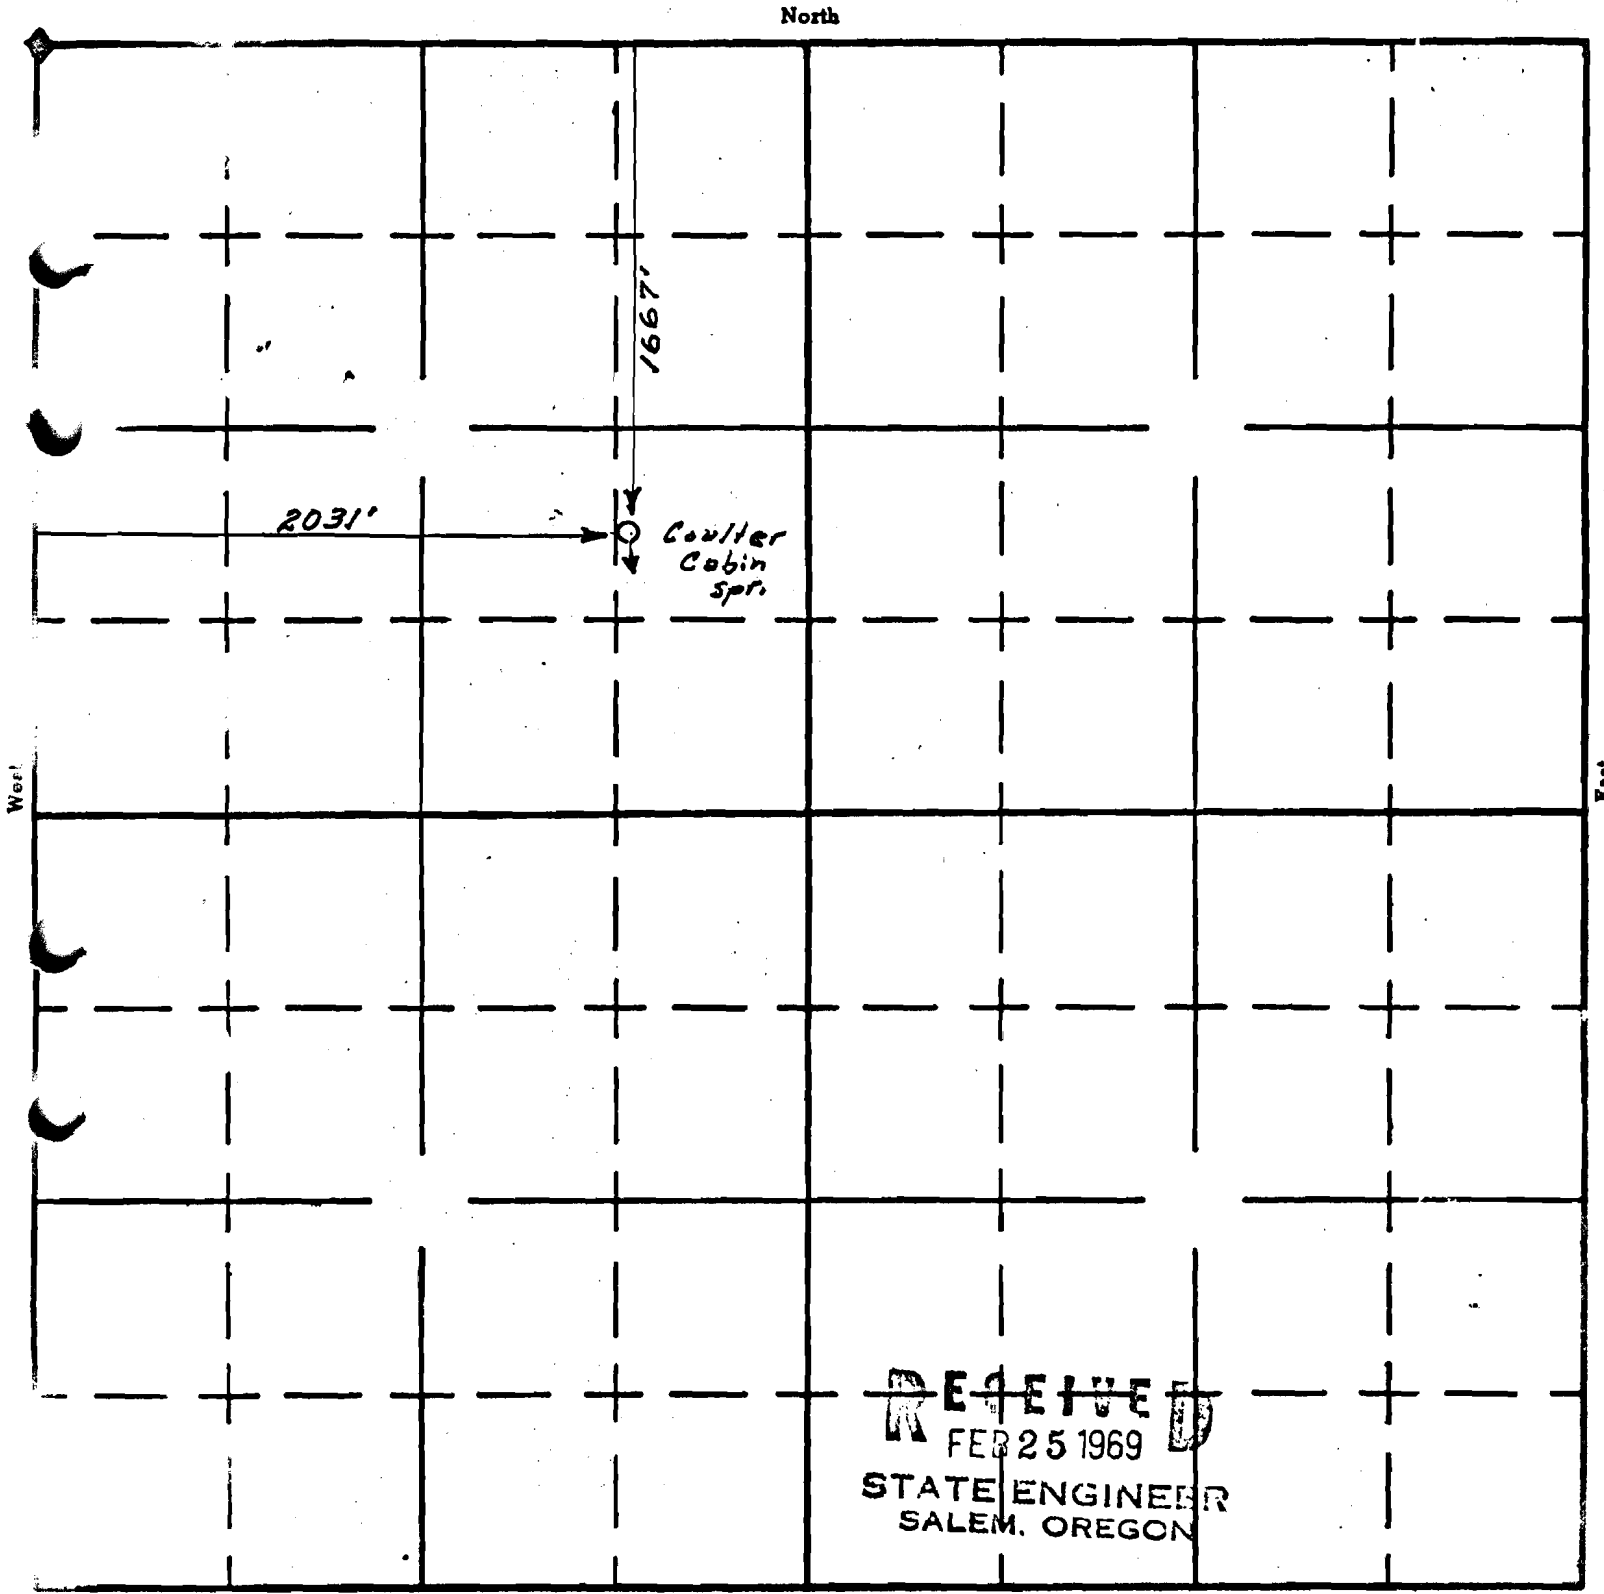

Miller Ck & misc.

RECEIVED
FEB 25 1969
STATE ENGINEER
SALEM, OREGON

APPLICATION No. 45800
PERMIT No. 34285