

14-1
1965

UNITED STATES
DEPARTMENT OF THE INTERIOR
BUREAU OF LAND MANAGEMENT


34286
Cancelled Sp. Or. Vol. 51, Pg. 1393
TRANSF 7757 change in use & correct
POD.

SIGNON

Oregon State Water Filings

TOWNSHIP 4/S., RANGE 14 1/2 E., W. M.

40667

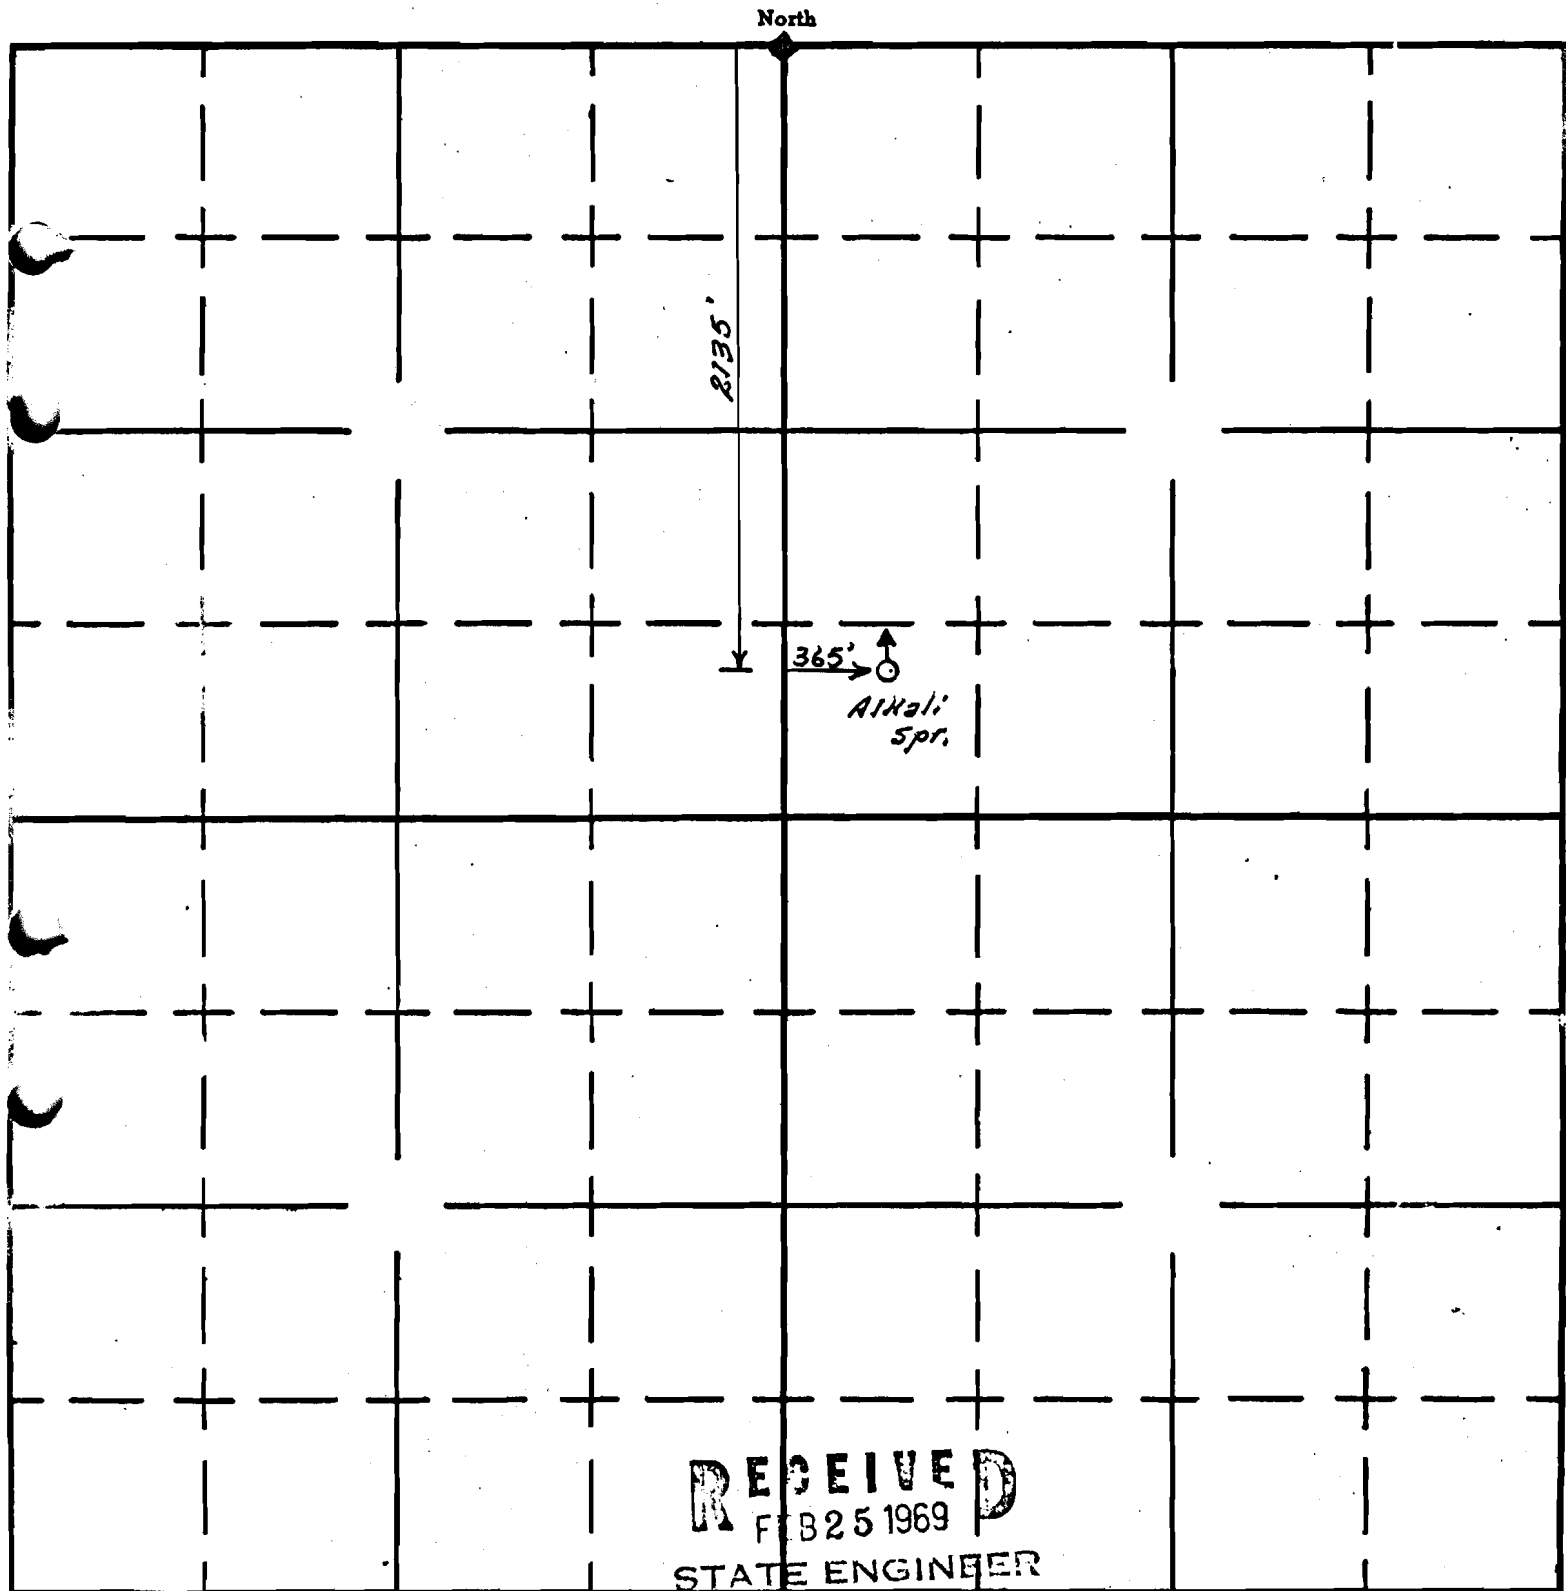

East Branch Lost R. Msc

APPLICATION No. 45804
PERMIT No. 31286