

P-7114-1
Nov. 1965

UNITED STATES
DEPARTMENT OF THE INTERIOR
BUREAU OF LAND MANAGEMENT

34287
40668


SECTION

34

Oregon State Water Filings

TOWNSHIP 40S., RANGE 14E., W. M.

North

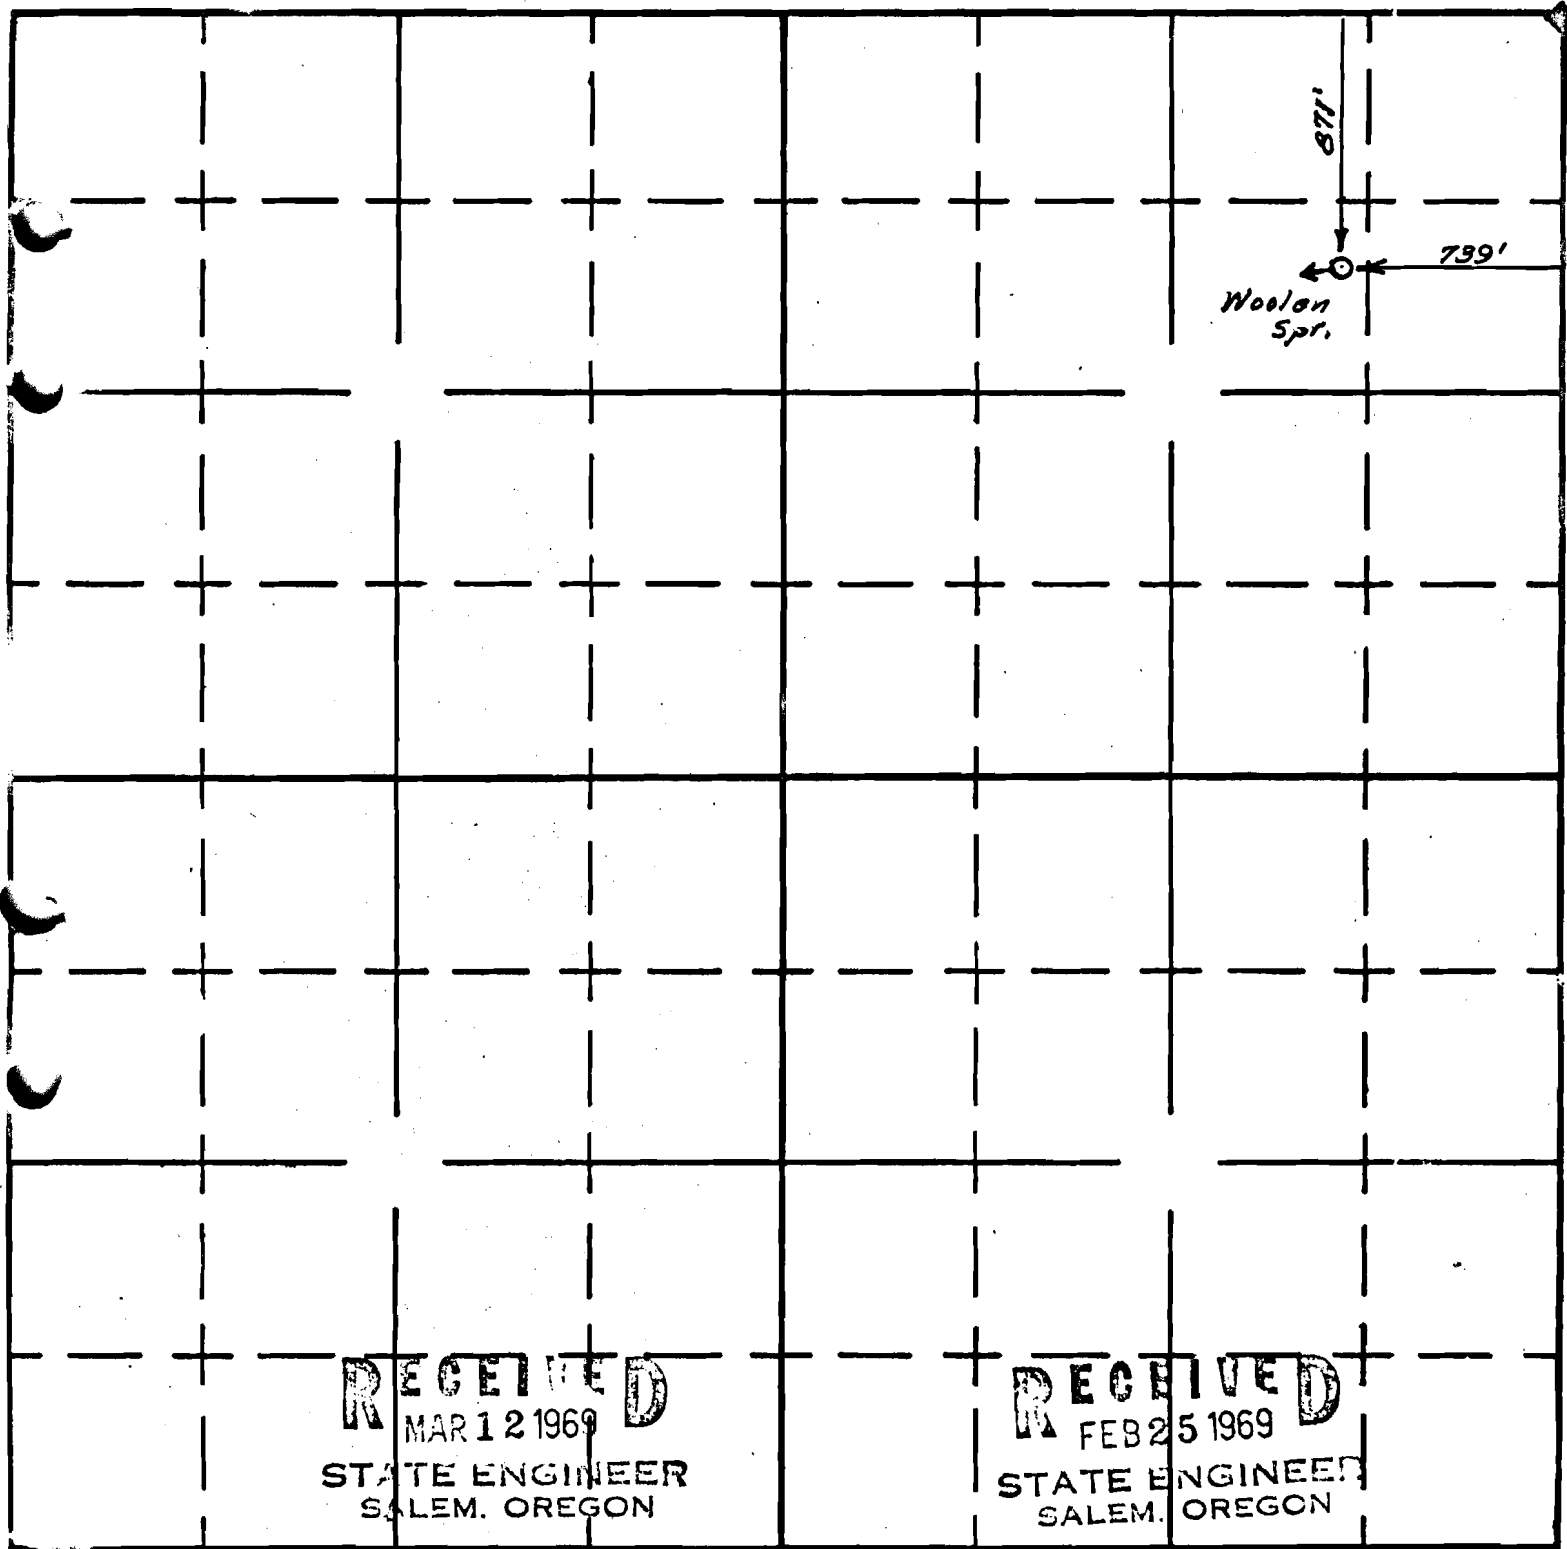

South

Lost to. Mic

APPLICATION No. 45805
PERMIT No. 34287