

P-7114-1
Nov. 1965

UNITED STATES
DEPARTMENT OF THE INTERIOR
BUREAU OF LAND MANAGEMENT

34288
40669


SECTION

30

Oregon State Water Filings

TOWNSHIP 39S., RANGE 14E., W. M.

North

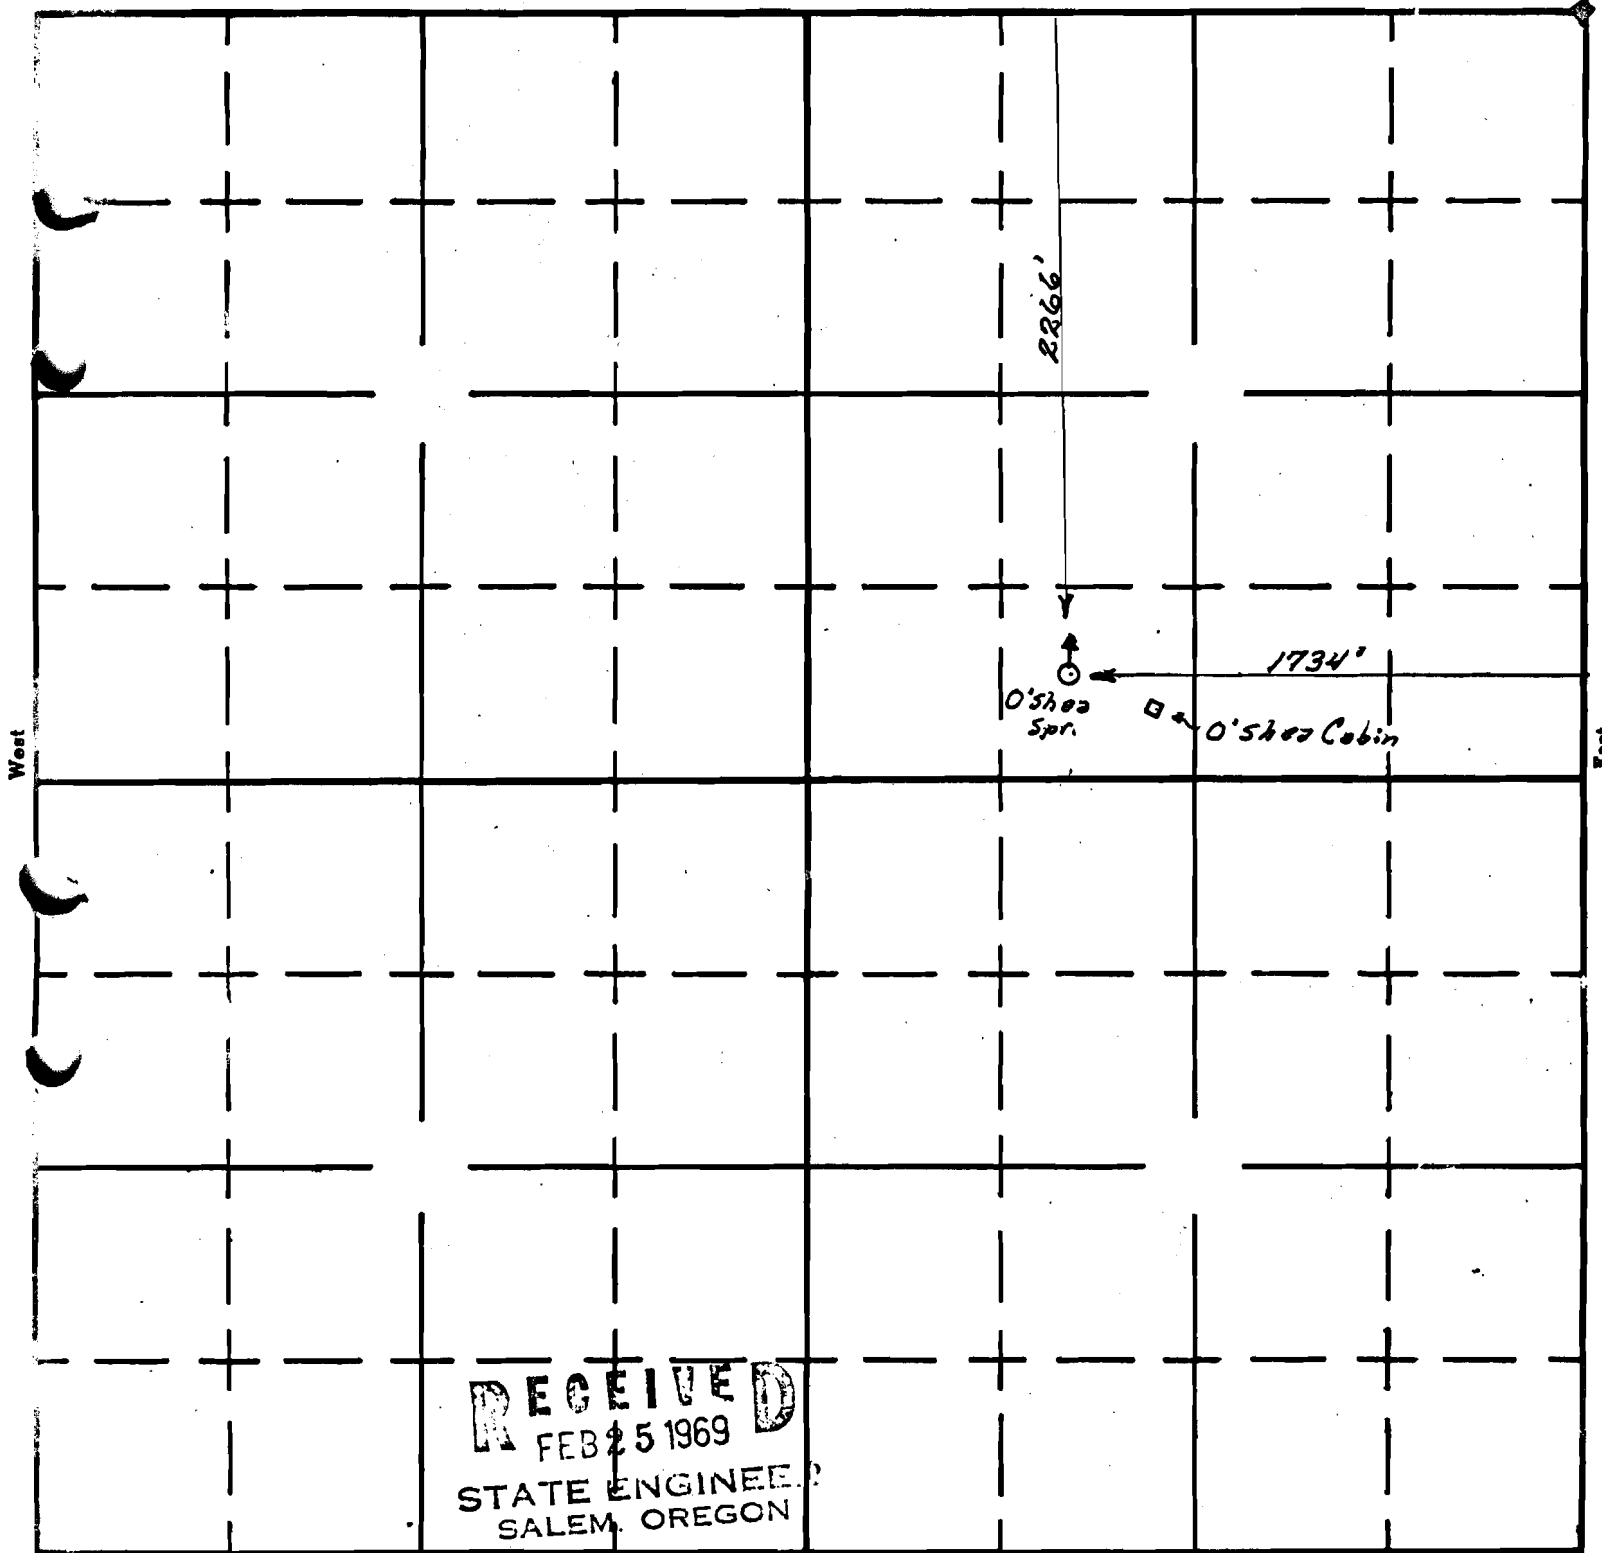

RECEIVED
FEB 25 1969
STATE ENGINEER
SALEM, OREGON

mile off E. line.

South

APPLICATION No. 45806

PERMIT No. 31288