

Form AI-187
March 1961

UNITED STATES
DEPARTMENT OF THE INTERIOR
BUREAU OF LAND MANAGEMENT


SECTION

SW⁴SE⁴ Sec 36

Oregon State Water Filings

TOWNSHIP 40S, RANGE 2SE, W. M.

North

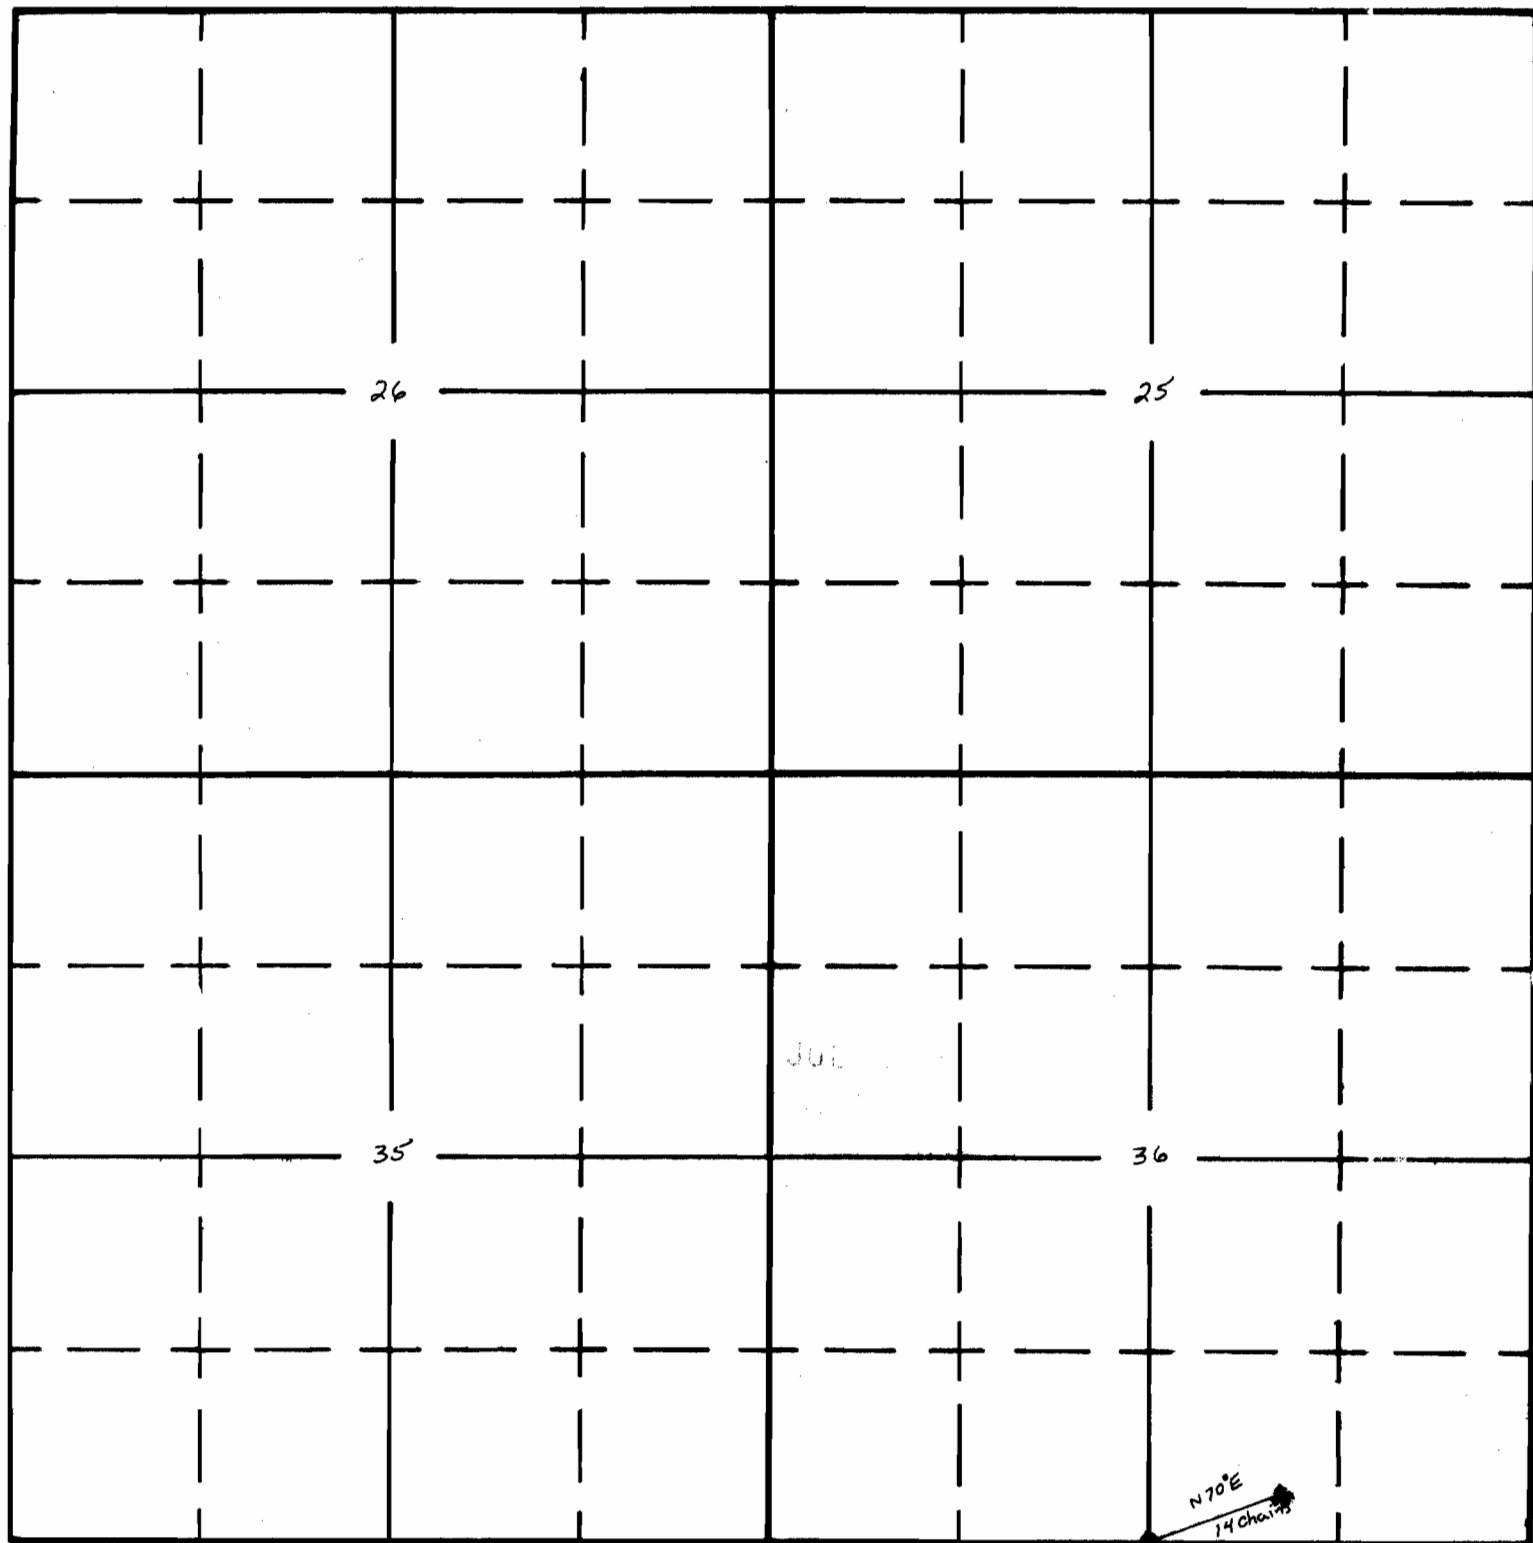

◆ Found Survey Corner

South

APPLICATION No. **35206**
PERMIT No. **28917**