

UNITED STATES
DEPARTMENT OF THE INTERIOR
BUREAU OF LAND MANAGEMENT


34161
40674

13

SECTION 8

Oregon State Water Filings

TOWNSHIP 38S, RANGE 24E, W. M.

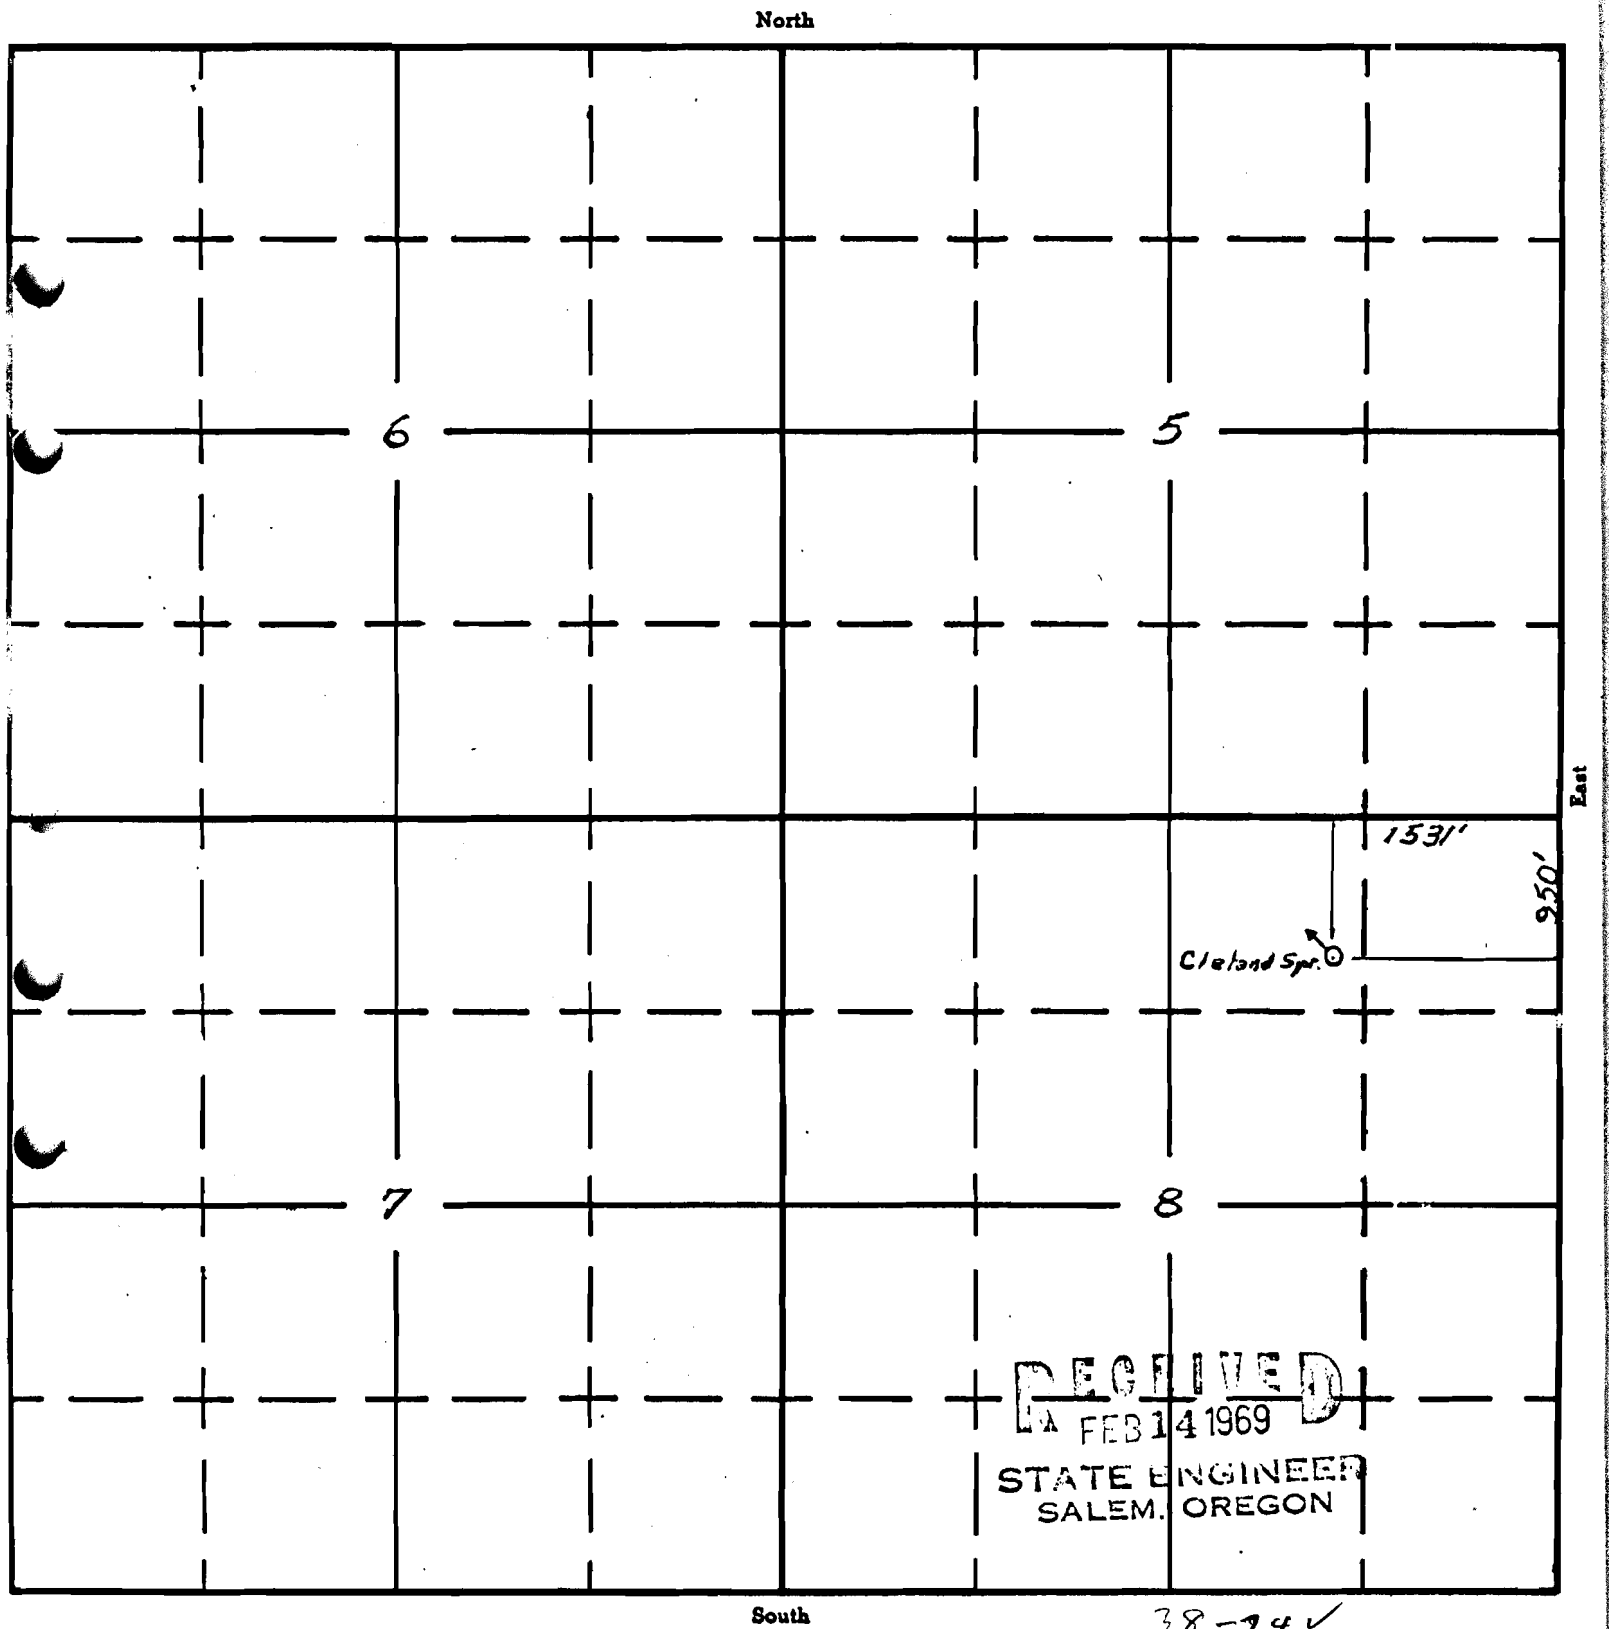

RECEIVED
FEB 14 1969
STATE ENGINEER
SALEM, OREGON

38-24 ✓
APPLICATION No. 45766
PERMIT No. 34161