

UNITED STATES  
DEPARTMENT OF THE INTERIOR  
BUREAU OF LAND MANAGEMENT

13

SECTION


22

# Oregon State Water Filings

34162  
40675

TOWNSHIP 38S, RANGE 23E, W. M.

North

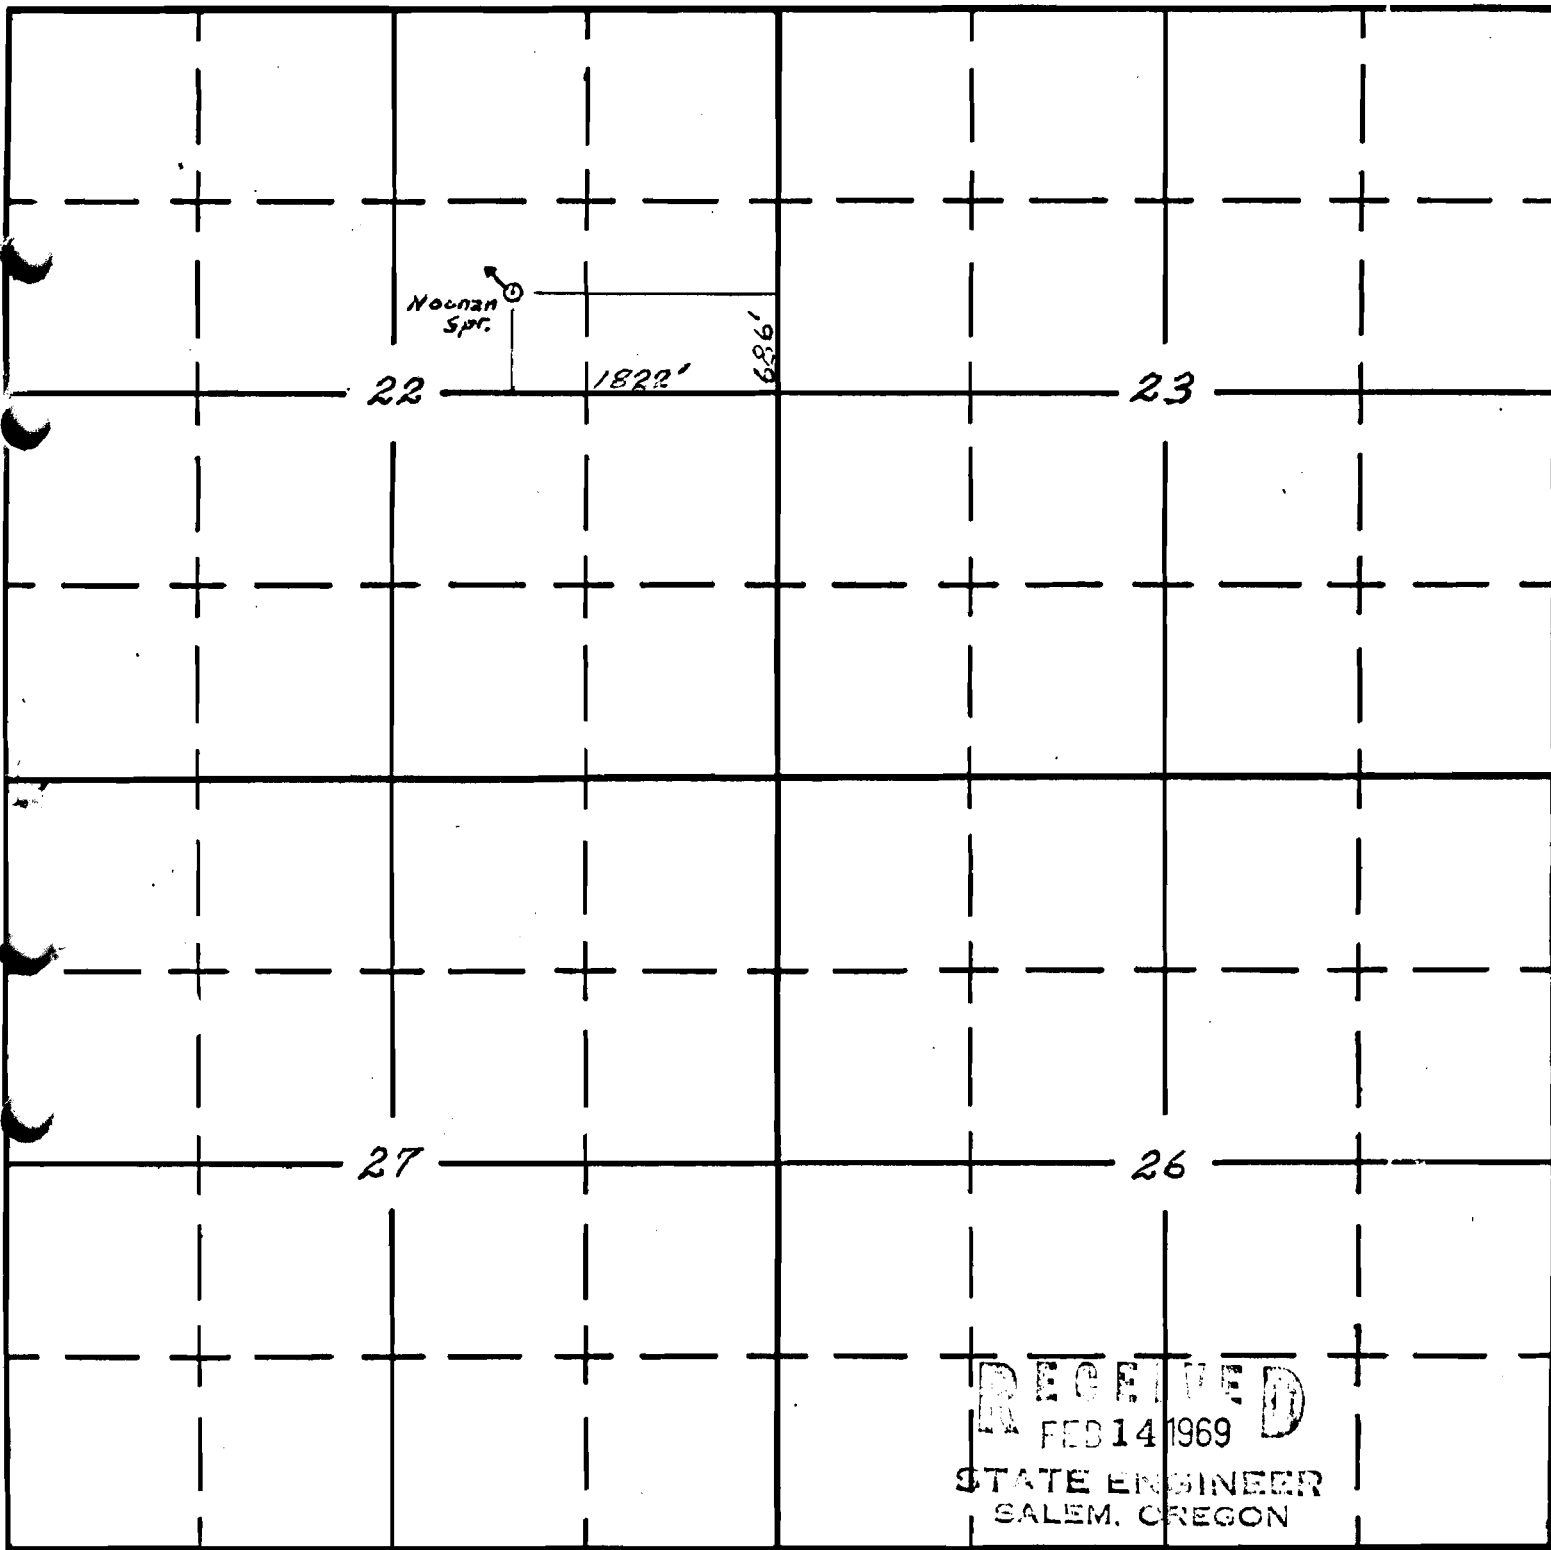

South

RECEIVED  
FEB 14 1969  
STATE ENGINEER  
SALEM, OREGON

38-23 ✓

APPLICATION No. 45767

PERMIT No. 34162