

March 1961

DEPARTMENT OF THE INTERIOR
BUREAU OF LAND MANAGEMENT

P. 34163


40676

SECTION 2

Oregon State Water Filings

TOWNSHIP 38S, RANGE 23E, W. M.

North

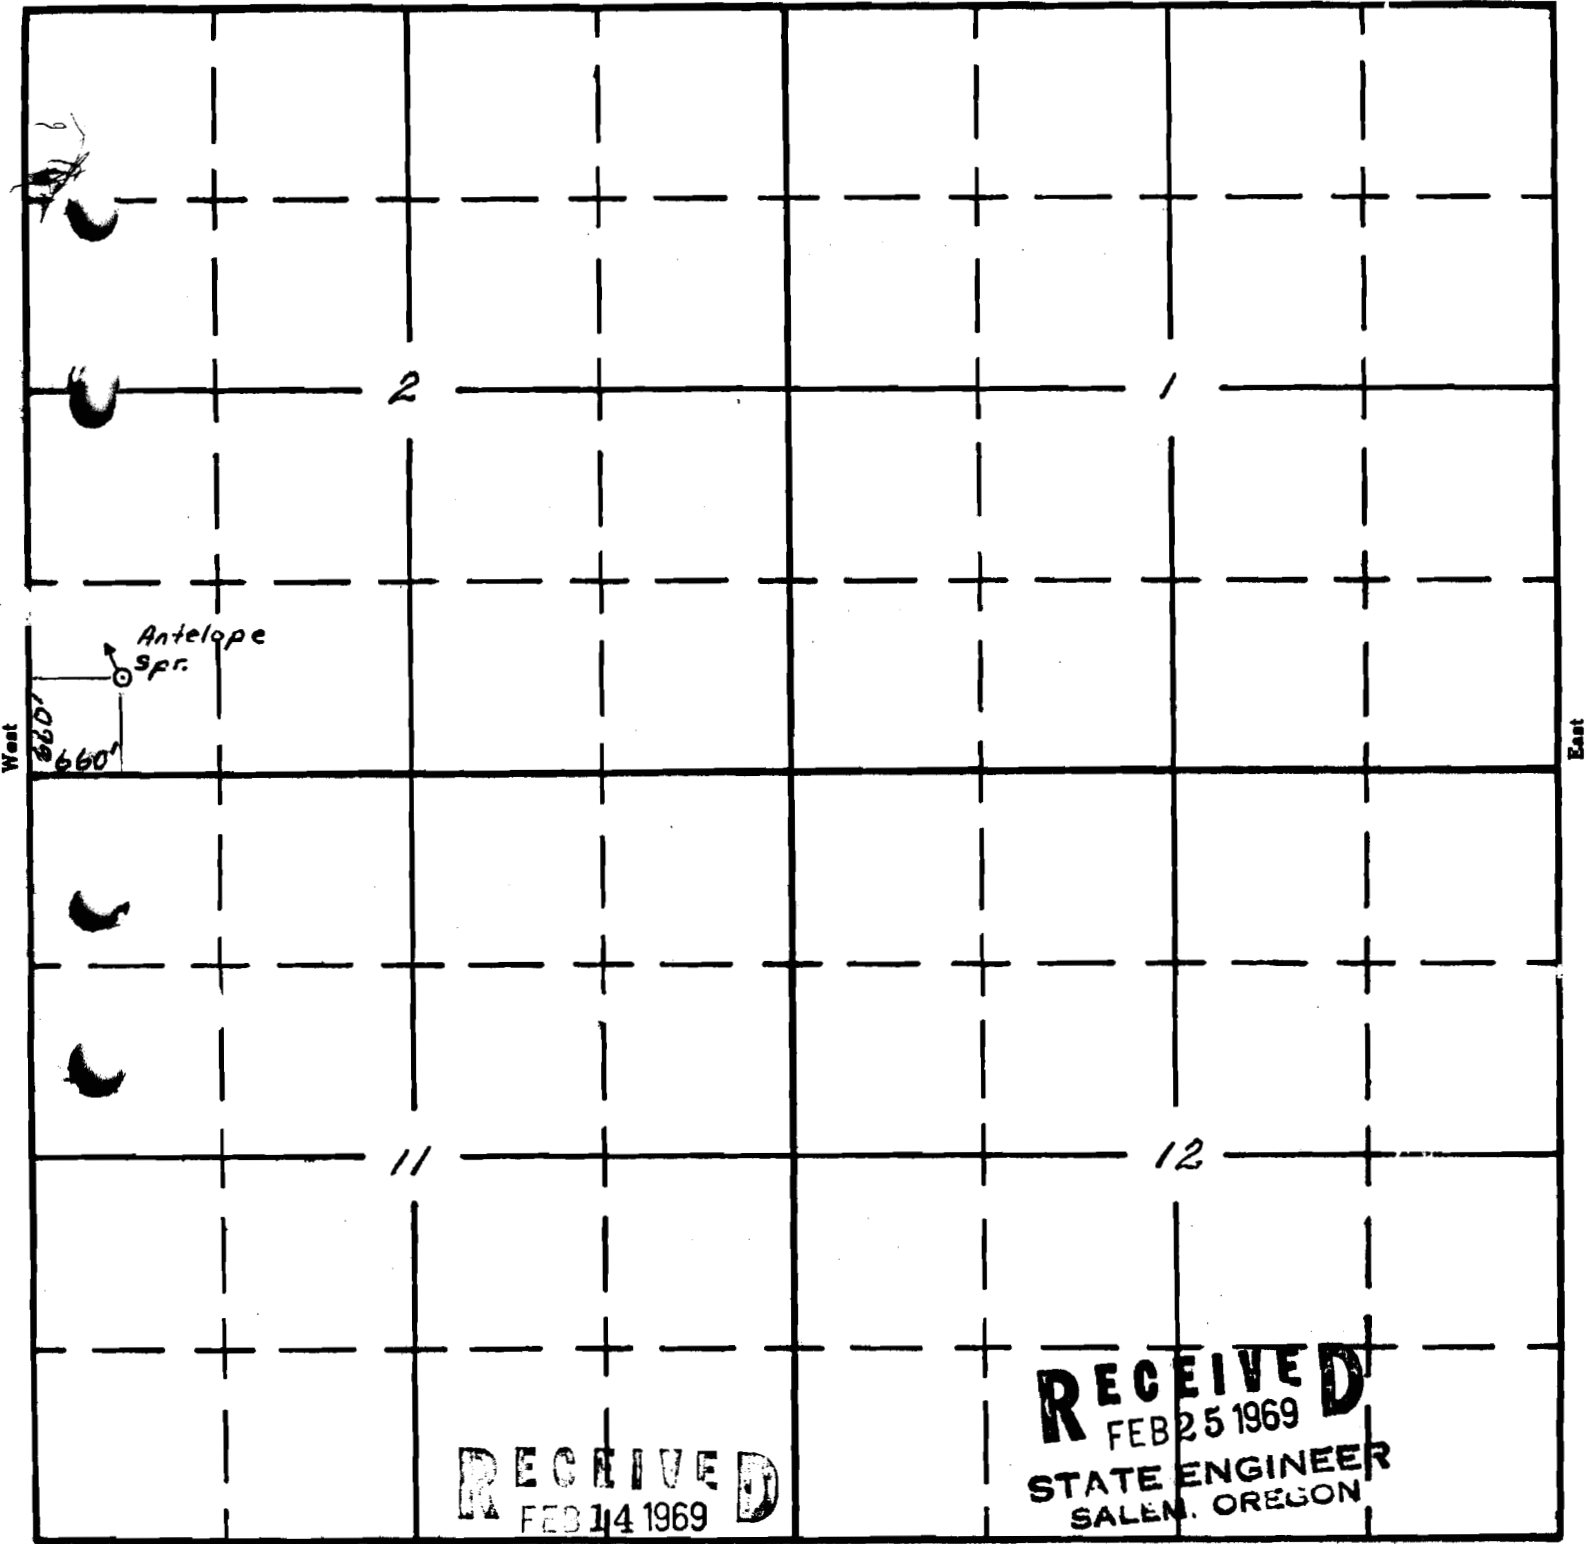

STATE ENGINEER
SALEM, OREGON

APPLICATION No. 45768
PERMIT No. 34163