

UNITED STATES
DEPARTMENT OF THE INTERIOR
BUREAU OF LAND MANAGEMENT


73
34166
40678

SECTION 10

Oregon State Water Filings

TOWNSHIP 41S., RANGE 23E., W. M.

North

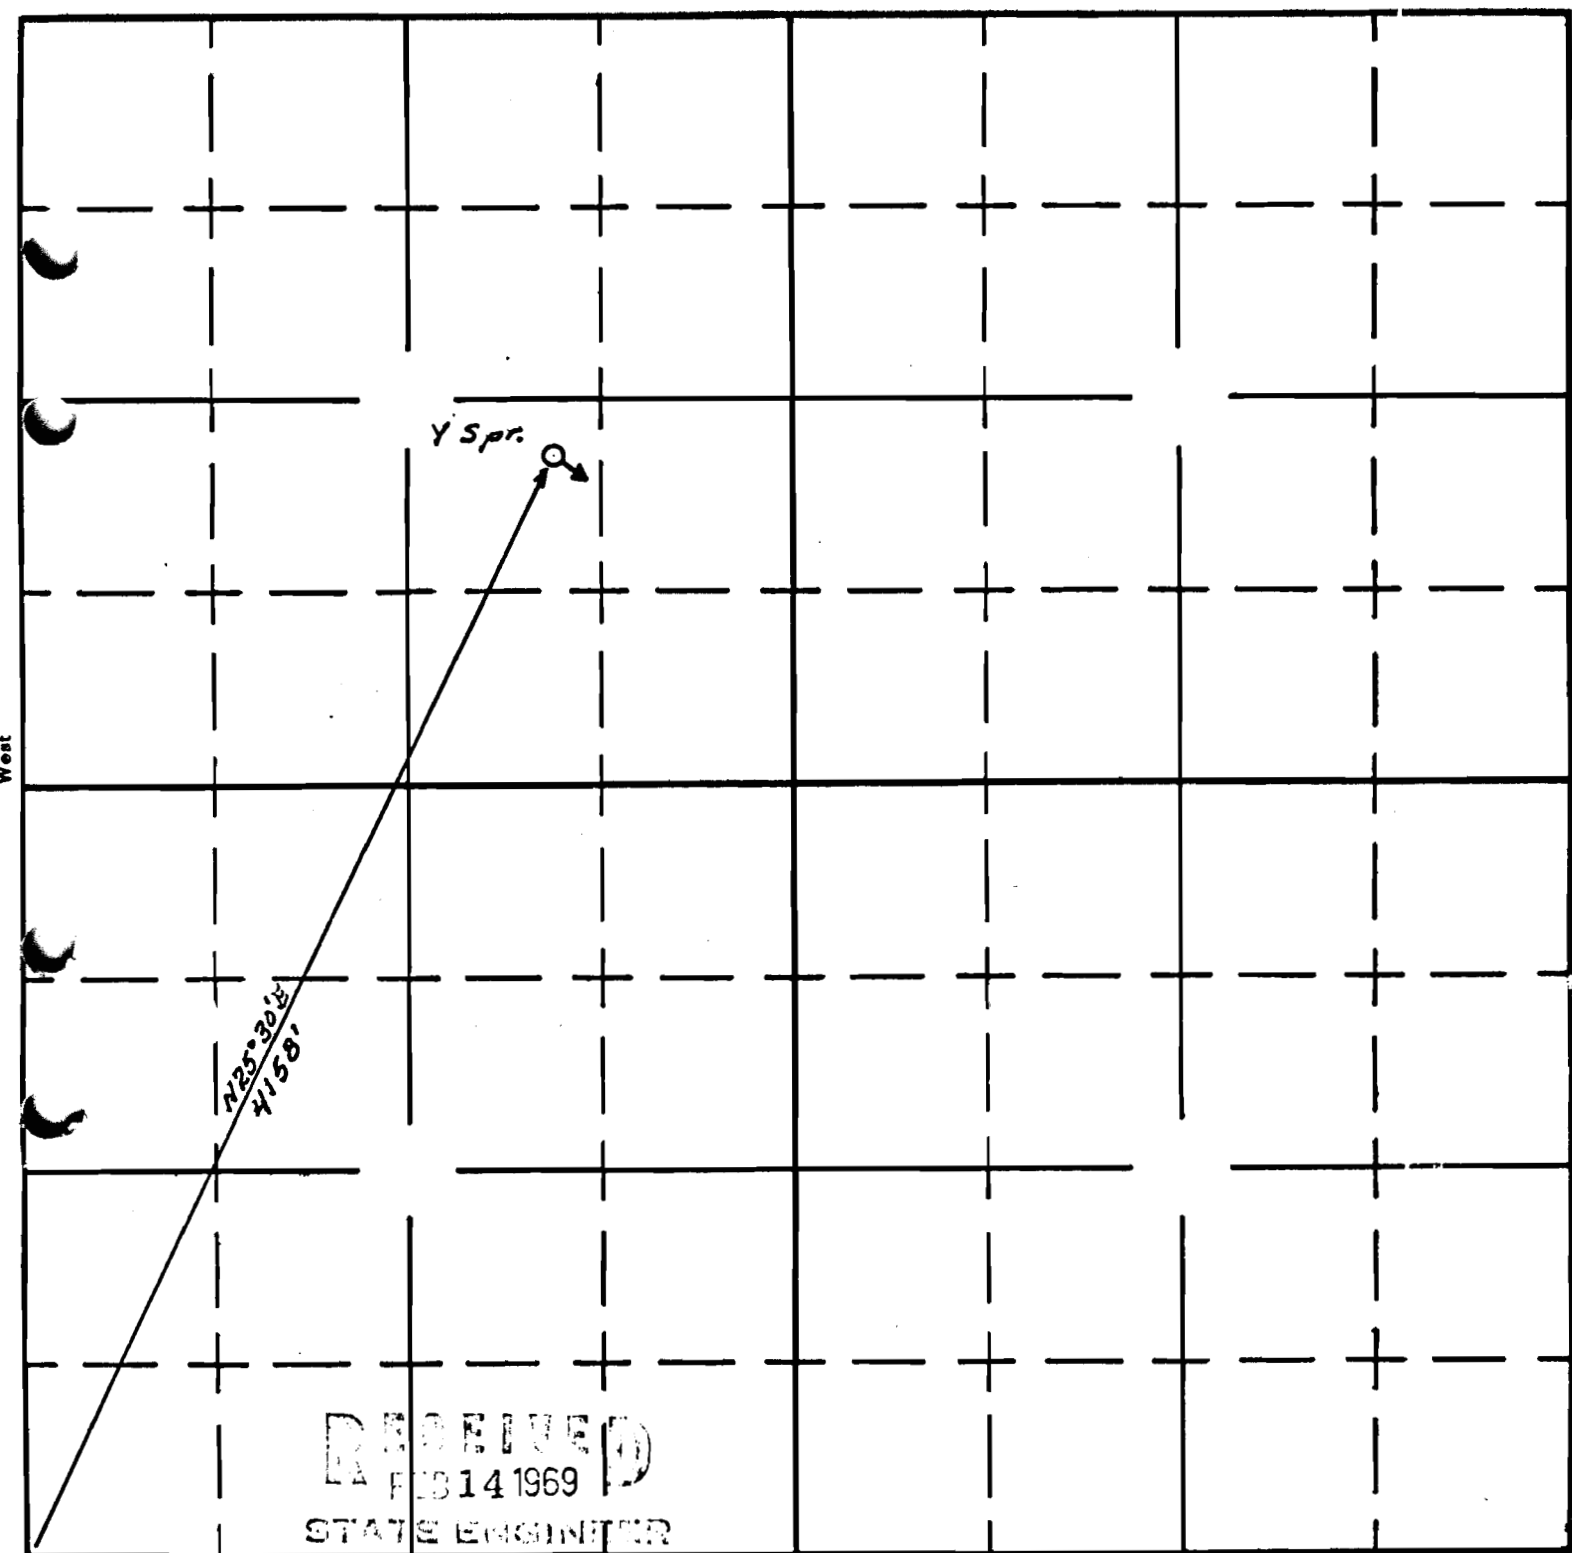

East

South

41-23 ✓
APPLICATION No. 45771
PERMIT No. 34166