


T.13S., R.4W., W.M.

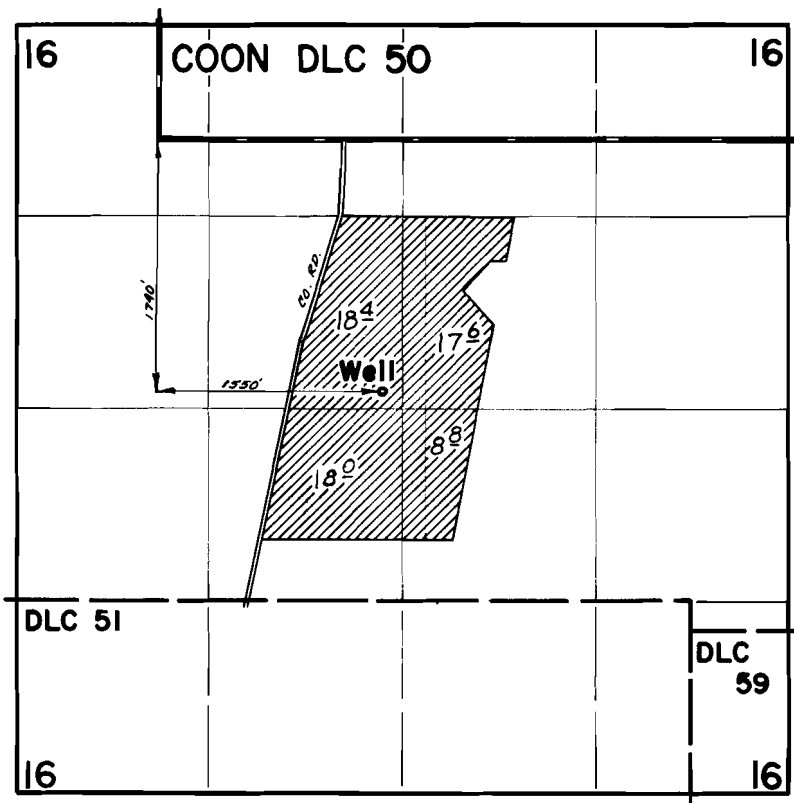

FINAL PROOF SURVEY
UNDER

Application No. G-4475 Permit No. G-4217
IN NAME OF

RICHARD D. AND DORIS JEAN PIMM

Surveyed Oct. 2, 1973, by D. Norby