


T.10S., R.2W., W.M.

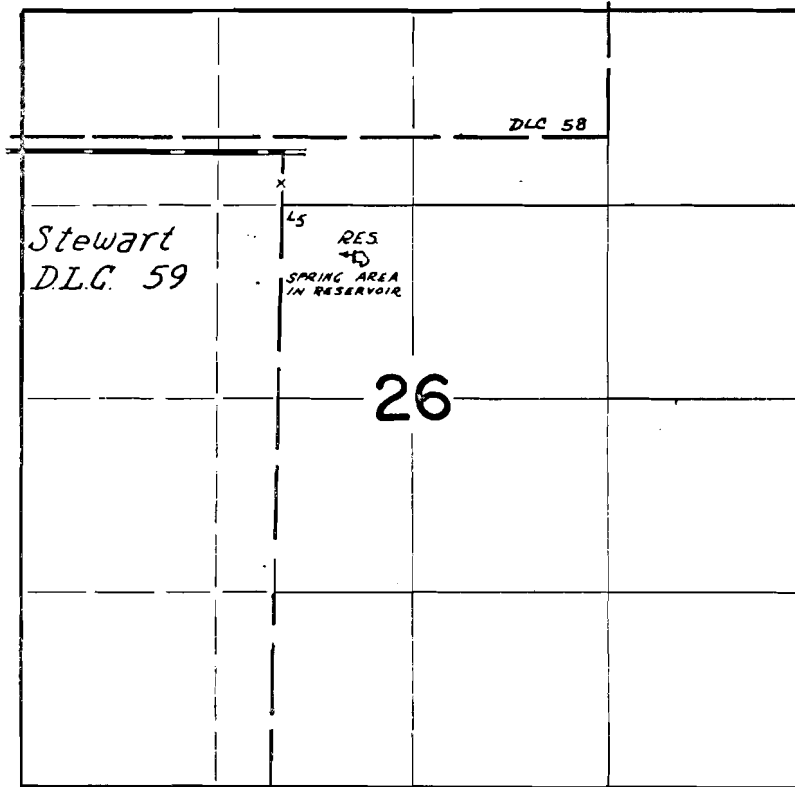

DIV. PT. LOCATED: 700' S & 300' E FROM NE COR. STEWART DLC 59

FINAL PROOF SURVEY UNDER

Application No. R-42710 42711 Permit No. R-4848 31210
IN NAME OF

RICHARD V. and ALLICE E. KIRKPATRICK

Surveyed Aug. 28 1972, by D. Norby