


T.I.S.R.I.W.W.M.

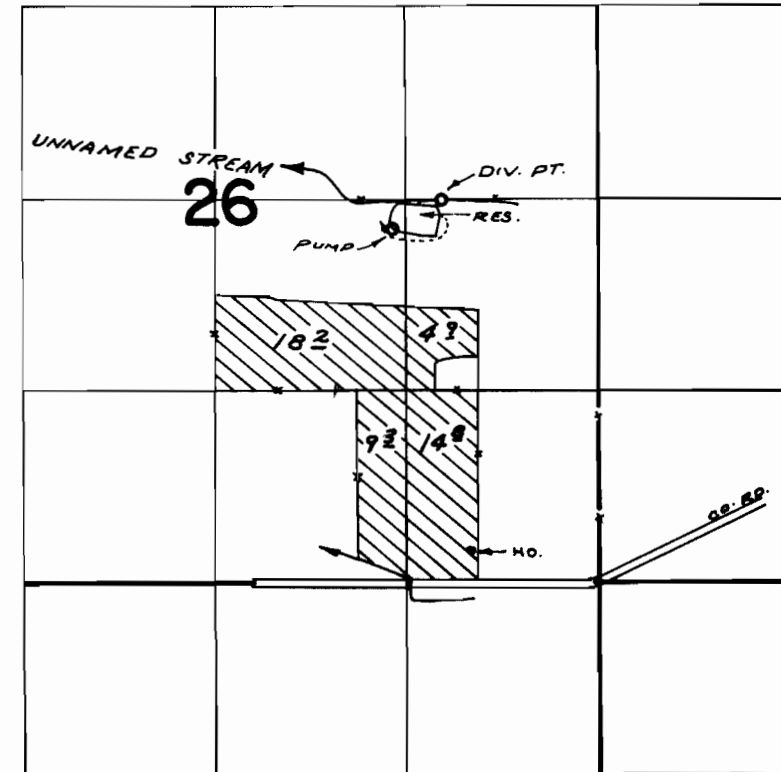

DIV. PTS. LOC: STR - 1310' N. & 1540' E. ; RES. - 1110' N. & 1200' E.,
BOTH FROM S.W. COR. NW & SE 1/4 SEC. 26

FINAL PROOF SURVEY UNDER

R-45158 R-5329
Application No. 45159 Permit No. 33739
IN NAME OF

RICHARD E. REATHA A. KLUSER

Surveyed Nov. 8, 1972, by R. MUGGEN