


T. 13S., R. 2E., W.M.

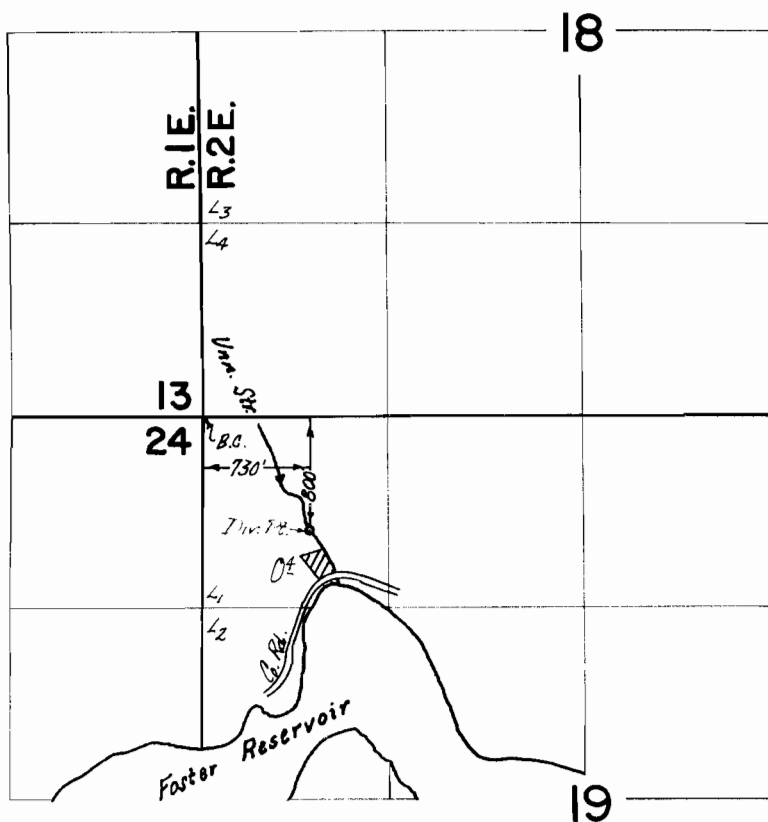

FINAL PROOF SURVEY
UNDER

Application No. 42902 Permit No. 32060
IN NAME OF

PEARL E. ZURCHER

Surveyed 20 Sept. 19 72, by D. NORBY